

Walthall
E 60
9-3-69

MISSISSIPPI
 BOARD OF WATER COMMISSIONERS
 416 North State Street
 Jackson, Mississippi 39201

CODED

CODED

WATER WELL DRILLERS LOG

9-3
 date well completed

1969 Fitzgerald Well Serv
 firm name

Walthall
 county well located

LANDOWNER:

Ray Jackson
RR Tybunon Miss.
 (mailing address)

description of formations encountered

from to

<u>Red Clay</u>	<u>0</u>	<u>15</u>
<u>Red sand</u>	<u>15</u>	<u>30</u>
<u>Red gravel</u>	<u>60</u>	<u>68</u>
<u>white clay</u>	<u>68</u>	<u>130</u>
<u>Fines sand</u>	<u>130</u>	<u>145</u>
<u>Coarse sand & gravel</u>	<u>145</u>	<u>154</u>

WELL LOCATION:

sec. 1 T 2 N R 9 E
7 miles SW of Tybunon
 (distance) (direction) (nearest town)

WELL PURPOSE: Home
 (home, irrigation, municipal, industrial)

WELL COMPLETION DATA:


- (1) diameter (inches) 4
- (2) total depth (feet) 154
- (3) static water level (feet) 80 below above top of ground.
- (4) casing plastic, 148,
 (material) (depth)
4 if telescope see back.
 (size)
- (5) screen 6, 148
 (length) (depth to top)
4, plastic
 (size) (material)
- (6) pump 3/4, 6
 (HP) (yield gpm)
Electric
 (type power)
- (7) electric log no
 (yes or no)
 (organization running log)
- (8) how well bottom plugged usual

DRILLERS REMARKS:

SEP 18 1969
 MISSISSIPPI BOARD OF WATER COMMISSIONERS

If well telescopes please sketch and show depths.

GROUND LEVEL

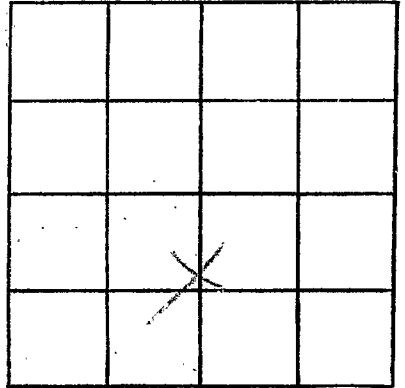

SECTION

Please indicate well location X.

ADDITIONAL INFORMATION

If more than one screen,
show locations of each on sketch.