

**WALTHALL**  
**E 62**  
**10-27-69**

MISSISSIPPI  
 BOARD OF WATER COMMISSIONERS  
 416 North State Street  
 Jackson, Mississippi 39201

CODED

WATER WELL DRILLERS LOG

10-27 1969 *Fitzgerald well dr* *Walthall*  
 date well completed firm name county well located

LANDOWNER:  
*Lee Fleck Brunfield*  
*R.R. Tylertown Miss.*  
 (mailing address)

description of formations encountered	from	to
<i>Red clay</i>	<i>0</i>	<i>20</i>
<i>Red sand</i>	<i>20</i>	<i>90</i>
<i>Red gravel</i>	<i>90</i>	<i>100</i>
<i>course sand</i>	<i>100</i>	<i>128</i>

WELL LOCATION:  
 sec. 4 T. 2 N. R. 10 E  
 S W  
6 miles W of Tylertown  
 (distance) (direction) (nearest town)

WELL PURPOSE: Home  
 (home, irrigation, municipal, industrial)

- WELL COMPLETION DATA:
- (1) diameter (inches) 4
  - (2) total depth (feet) 128
  - (3) static water level (feet) 90 below above top of ground.
  - (4) casing Plastic, 122,  
 (material) (depth)  
4 if telescope see back.  
 (size)
  - (5) screen 6, 122  
 (length) (depth to top)  
4, Plastic  
 (size) (material)
  - (6) pump ?, ?  
 (HP) (yield gpm)  
70  
 (type power)
  - (7) electric log no  
 (yes or no)  
 (organization running log)
  - (8) how well bottom plugged wood plug


DRILLERS REMARKS:

NOV 21 1969

MISS. Bd. of  
 WATER COMMISSIONERS

If well telescopes please sketch and show depths.

GROUND LEVEL

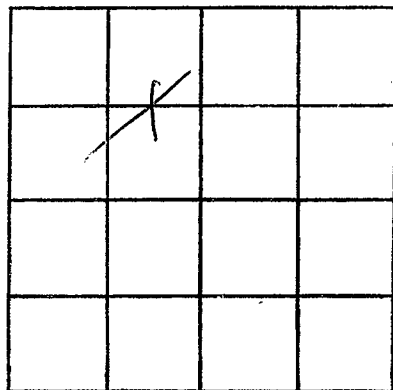

SECTION 4

Please indicate well location X.

ADDITIONAL INFORMATION

If more than one screen,  
show locations of each on sketch.