

WALTHALL

E 63

11-26-69

MISSISSIPPI
 BOARD OF WATER COMMISSIONERS
 416 North State Street
 Jackson, Mississippi 39201

CODED

CODED

WATER WELL DRILLERS LOG

11-26 1969
date well completed

Fitzgerald Well Drilling
firm name

Walthall
county well located

LANDOWNER:

Marshall Smith

R.R. Tylertown, Miss.
(mailing address)

description of formations encountered

from

to

Red clay	0	20
Red sand	20	80
Red gravel	80	120
Red sand	120	140
Coarse sand	140	152

WELL LOCATION:

sec. 28 T 3 N R 10 E
 S W
 4 miles W of Tylertown
 (distance) (direction) (nearest town)

WELL PURPOSE:

Home
(home, irrigation, municipal, industrial)

WELL COMPLETION DATA:

- (1) diameter (inches) 4
- (2) total depth (feet) 152
- (3) static water level (feet) 110 below top of ground.
- (4) casing plastic 144 (material) (depth)
- 4 (size) If telescope see back.
- (5) screen 3 144 (length) (depth to top)
- 4 (size) plastic (material)
- (6) pump 1/2 10 (HP) (yield gpm)
- Electric (type power)
- (7) electric log 23 (yes or no)
- (organization running log)
- (8) how well bottom plugged Woodpecker


DRILLERS REMARKS:

DEC 22 1969

MISS. BD. OF WATER COMMISSIONERS

If well telescopes please sketch and show depths.

GROUND LEVEL

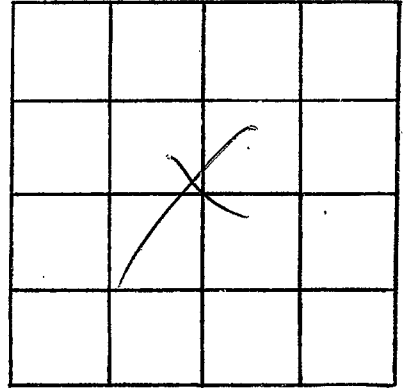

SECTION 28

Please indicate well location X.

ADDITIONAL INFORMATION

If more than one screen,
show locations of each on sketch.