

Walthall  
E 65  
4-3-70

MISSISSIPPI  
BOARD OF WATER COMMISSIONERS  
416 North State Street  
Jackson, Mississippi 39201

COPIED

WATER WELL DRILLERS LOG

~~4-3~~ 4-3 1970 date well completed      Fitzgerald Well Co. firm name      Walthall county well located

LANDOWNER:  
Joe W. Roberts  
RR. Tylertown miss.  
(mailing address)

description of formations encountered	from	to
red clay	0	20
red chalk	20	60
red sand	60	90
white chalk	90	115
coarse sand	115	123
white chalk	123	129

WELL LOCATION:  
sec. 6 T 2 N R 10 E  
S W  
9 miles W of Tylertown  
(distance) (direction) (nearest town)

WELL PURPOSE: Home  
(home, irrigation, municipal, industrial)

- WELL COMPLETION DATA:
- (1) diameter (inches) 4
  - (2) total depth (feet) 129
  - (3) static water level (feet) 100 below top of ground.
  - (4) casing Plastic, 117 (material) (depth)  
4 (size) If telescope see back.
  - (5) screen 6 117 (length) (depth to top)  
4 (size) Plastic (material)
  - (6) pump 6 (HP) 6 (yield gpm)  
Elec (type power)
  - (7) electric log no (yes or no)  
(organization running log)
  - (8) how well bottom plugged Good plug

COPIED


APR - 6 1970

MISS. BD. OF  
WATER COMM.

DRILLERS REMARKS:

If well telescopes please sketch and show depths.

GROUND LEVEL

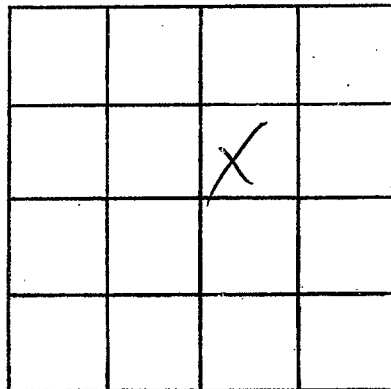

SECTION 6

Please indicate well location X.

ADDITIONAL INFORMATION

If more than one screen, show locations of each on sketch.