

WALTHALL
E 66
1- 70

MISSISSIPPI
BOARD OF WATER COMMISSIONERS
416 North State Street
Jackson, Mississippi 39201

CODED
CODED

WATER WELL DRILLERS LOG

JAN. 1970 E.B. SHERBARD WALTHALL
date well completed firm name county well located

LANDOWNER:
PARLEY BRELAND
TYLERTOWN, Miss.
(mailing address)

description of formations encountered	from	to
INCONSISTENT SAND GRAVEL		
CLAY MIXED GRAVEL-SAND	120'	142'
CLAY CLAY BASE		

WELL LOCATION:
sec. 21 T. 2 N. R. 10 E
4 miles W Tylertown
(distance) (direction) (nearest town)

WELL PURPOSE:
(home) irrigation, municipal, industrial

WELL COMPLETION DATA:

(1) diameter (inches) 2"

(2) total depth (feet) 142'

(3) static water level (feet) 118' below top of ground.

(4) casing Plastic, 142' (material) (depth)
2" (size) If telescope see back.

(5) screen 3' (length) (depth to top)
2 1/2" (size) S.S. (material)

(6) pump 1 1/2 (HP) 8 (yield gpm)

(type power)

(7) electric log (yes or no) (no)

(organization running log)

(8) how well bottom plugged BN

CODED
CODED


FEB 5 - 1970

MISS. DD. 01
WATER CC 01

DRILLERS REMARKS:

If well telescopes please sketch and show depths.

GROUND LEVEL

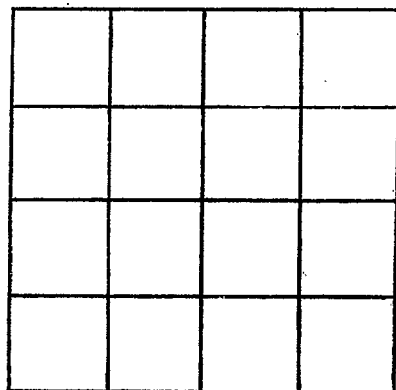

SECTION _____

Please indicate well location X.

ADDITIONAL INFORMATION

If more than one screen, show locations of each on sketch.