

Walthall
E 68
4-9-70

MISSISSIPPI
BOARD OF WATER COMMISSIONERS
416 North State Street
Jackson, Mississippi 39201

CODED

WATER WELL DRILLERS LOG

Apr-9 1970 Fitzgerald Well Co Walthall
date well completed firm name county well located

LANDOWNER:
Turkino Jones
B.R. Fulton Min.
(mailing address)

description of formations encountered	from	to
Reel Clay	0	20
Reel gravel	20	120
Reel Sand	120	140
Coarse Sand + gravel	140	176

WELL LOCATION:
sec. 25 T 20 N R 10 E
S
8 miles W of Fulton
(distance) (direction) (nearest town)

WELL PURPOSE: Home
(home, irrigation, municipal, industrial)

- WELL COMPLETION DATA:
- (1) diameter (inches) 4
 - (2) total depth (feet) 176
 - (3) static water level (feet) 140 below above top of ground.
 - (4) casing Plastic 170
(material) (depth)
4 if telescope see back.
(size)
 - (5) screen 6 170
(length) (depth to top)
4 Plastic
(size) (material)
 - (6) pump 1/2 6
(HP) (yield gpm)
elec
(type power)
 - (7) electric log no
(yes or no)

CODED

(organization running log)

(8) how well bottom plugged Wool py


APR 29 1970

MISS. BD. OF
WATER COMM.

DRILLERS REMARKS:

If well telescopes please sketch and show depths.

GROUND LEVEL

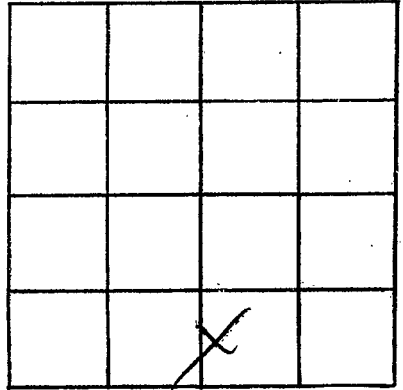

SECTION 25

Please indicate well location X.

ADDITIONAL INFORMATION

If more than one screen, show locations of each on sketch.