

MISSISSIPPI
BOARD OF WATER COMMISSIONERS
416 North State Street
Jackson, Mississippi 39201

CODED

WATER WELL DRILLERS LOG

Walshall
E 69
4-27-70

Apr 27 1970 To Fitzgerald Drilling Co. firm name
Walshall county well located

LANDOWNER:
Emerson Bates
RR. Lyborton
(mailing address)

WELL LOCATION:
sec. 4 T 20 N R 10 W
2 miles NW of MESA
(distance) (direction) (nearest town)

description of formations encountered	from	to
Red Clay	0	20
Red Soil	20	80
Red gravel	80	110
Coarse Sand & gravel	110	124

WELL PURPOSE: Home
(home, irrigation, municipal, industrial)

WELL COMPLETION DATA:

(1) diameter (inches) 4

(2) total depth (feet) 124

(3) static water level (feet) 98 below top of ground.

(4) casing plastic 116 (material) (depth)
If telescope see back.

(5) screen 8 116 (length) (depth to top)
4 plastic (size) (material)

(6) pump 1/2 4 (HP) (yield gpm)
Electric (type power)

(7) electric log Yes (yes or no)
(organization running log)

(8) how well bottom plugged wood peg

CODED


APR 29 1970

MISS. BD. OF WATER COMM.

DRILLERS REMARKS:

If well telescopes please sketch and show depths.

GROUND LEVEL

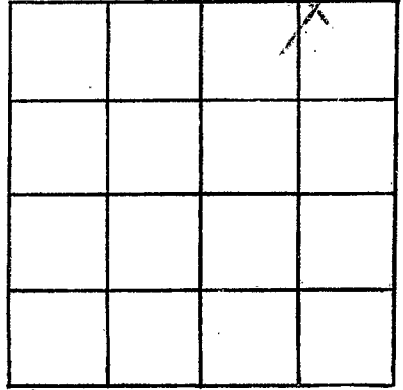

SECTION 4

Please indicate well location X.

ADDITIONAL INFORMATION

If more than one screen, show locations of each on sketch.