

WALTHALL

E71

9-10-70

MISSISSIPPI
 BOARD OF WATER COMMISSIONERS
 416 North State Street
 Jackson, Mississippi 39201

CODED

WATER WELL DRILLERS LOG

9-10

19

70 *Walthall Well*

Walthall

date well completed

firm name

county well located

LANDOWNER:

Velma Parker

RR Tyluta Miss.
(mailing address)

WELL LOCATION:

sec. *15* T *2* N R *10* E

2 miles *W* of *Tyluta*
(distance) (direction) (nearest town)

WELL PURPOSE: *Home*
(home, irrigation, municipal, industrial)

WELL COMPLETION DATA:

- (1) diameter (inches) *4*
- (2) total depth (feet) *119*
- (3) static water level (feet) *50* below top of ground.
- (4) casing *Plastic*, *111*,
(material) (depth)
- 4* (size) if telescope see back.
- (5) screen *3*, *111*
(length) (depth to top)
- 4*, *Plastic*
(size) (material)
- (6) pump *1/2*, *6*
(HP) (yield gpm)
- Electric*
(type power)
- (7) electric log *Yes*
(yes or no)

(organization running log)

(8) how well bottom plugged *Well*

description of formations encountered

from to

<i>Red clay</i>	<i>0</i>	<i>22</i>
<i>Red sand</i>	<i>22</i>	<i>60</i>
<i>Red gravel</i>	<i>60</i>	<i>80</i>
<i>Red sand</i>	<i>80</i>	<i>100</i>
<i>Red sand</i>	<i>100</i>	<i>110</i>
<i>Coarse sub gravel</i>	<i>110</i>	<i>119</i>

CODED


SEP 14 1970

DRILLERS REMARKS:

MISS. Bd. of
WATER COMMISSIONERS

If well telescopes please sketch and show depths.

GROUND LEVEL

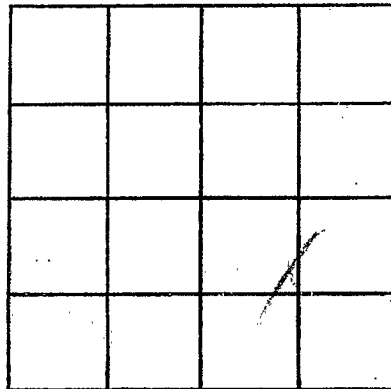

SECTION 15

Please indicate well location X.

ADDITIONAL INFORMATION

If more than one screen, show locations of each on sketch.