

Walthall
E 73
5-13-70

MISSISSIPPI
BOARD OF WATER COMMISSIONERS
416 North State Street
Jackson, Mississippi 39201

CODED

WATER WELL DRILLERS LOG

1970 MAY 13 date well completed
Fetner and Elbert Blount firm name
WALTHALL county well located

LANDOWNER: MARSHALL
Dexter
Tylertown MISS.
(mailing address)

description of formations encountered	from to	
	ft	ft
Red CLAY	0	40
SAND	40	75
SAND + GRAVEL	75	80
SAND	80	110
GRAVEL	110	118

WELL LOCATION:
sec. 26 T 2 N R 10 E
100 YDS miles S.W. Tylertown
(distance) (direction) (nearest town)

WELL PURPOSE: Home
(home, irrigation, municipal, industrial)

- WELL COMPLETION DATA:
- (1) diameter (inches) 6"
 - (2) total depth (feet) 118'
 - (3) static water level (feet) 53' below above top of ground.
 - (4) casing Plastic 1 1/2" (material) 118' (depth)
if telescope see back.
(size)
 - (5) screen 5' 113' (length) (depth to top)
1 1/2" Plastic (size) (material)
 - (6) pump (HP) (yield gpm)
ELECT. (type power)
 - (7) electric log (yes or no)
(organization running log)
 - (8) how well bottom plugged BACK
WASH VALVE

CODED


JUN 16 1970

MISS. BD. OF
WATER COMM.

DRILLERS REMARKS: F+W
Let PUMP - OLD well
MAX 80' RUNS OUT
WATER

If well telescopes please sketch and show depths.

GROUND LEVEL

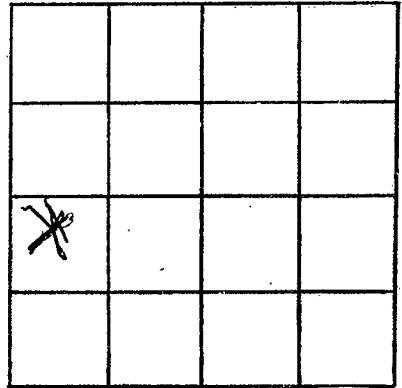

SECTION 26

Please indicate well location X.

ADDITIONAL INFORMATION

If more than one screen,
show locations of each on sketch.