

MISSISSIPPI
BOARD OF WATER COMMISSIONERS
416 North State Street
Jackson, Mississippi 39201

CODED

WATER WELL DRILLERS LOG

Walthall
E 74
6-11-70

6-11 1970 date well completed
Fitzgerald Chiles/Walthall firm name
county well located

LANDOWNER:
Wilton Reeling
R.R. Tylburn
(mailing address)

description of formations encountered	from	to
Red Clay	6	20
2 Red casing gravel	20	60
Red Sand	6	80
Coarse Sand	80	100
Blue Clay	100	100

WELL LOCATION:
sec. 15 T. 20 N. R. 10 E
4 miles WNW of Tylburn
(distance) (direction) (nearest town)

WELL PURPOSE: Home
(home, irrigation, municipal, industrial)

- WELL COMPLETION DATA:
- (1) diameter (inches) 4
 - (2) total depth (feet) 100
 - (3) static water level (feet) 90 below top of ground.
 - (4) casing (material) Plastic, (depth) 94
4 (size) if telescope see back.
 - (5) screen (length) 6, (depth to top) 94
4 (size) Plastic (material)
 - (6) pump (HP) 1/2, (yield gpm) 10
Cale (type power)
 - (7) electric log (yes or no) X
 - (organization running log)
 - (8) how well bottom plugged wood py

CODED


JUN 29 1970

DRILLERS REMARKS:
Shell

MISC. RD. OF
WATER COMM.

If well telescopes please sketch and show depths.

GROUND LEVEL

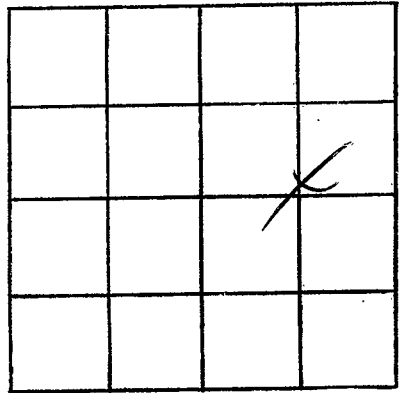

SECTION 15

Please indicate well location X.

ADDITIONAL INFORMATION

If more than one screen, show locations of each on sketch.