

Walthall
E 75
6-12-70

MISSISSIPPI
BOARD OF WATER COMMISSIONERS
416 North State Street
Jackson, Mississippi 39201

CODED

WATER WELL DRILLERS LOG

6-12 date well completed 1970 firm name Walthall county well located

LANDOWNER:
Buddy Henry
R.R. Lytleton Min.
(mailing address)

description of formations encountered	from	to
Red Clay	0	15
Red sand	15	170
Lower level ground	70	84

WELL LOCATION:
sec. 12 T 2 N R 10 E S 4
4 miles N of Lytleton
(distance) (direction) (nearest town)

WELL PURPOSE:
(home, irrigation, municipal, industrial)

- WELL COMPLETION DATA:
- (1) diameter (inches) 4
 - (2) total depth (feet) 84
 - (3) static water level (feet) 74 below top of ground
 - (4) casing plaster 76 (material) (depth)
4 (size) if telescope see back.
 - (5) screen 8 76 (length) (depth to top)
4 (size) plaster (material)
 - (6) pump 1 18 (HP) (yield gpm)
Elec (type power)
 - (7) electric log no (yes or no)
 - (organization running log)
 - (8) how well bottom plugged good


CODED

DRILLERS REMARKS:

JUN 29 1970
MISS. BD. OF
WATER

If well telescopes please sketch and show depths.

GROUND LEVEL

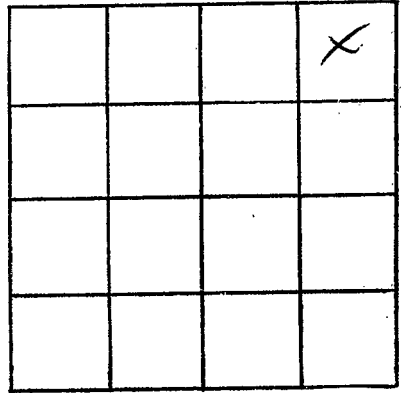

SECTION 12

Please indicate well location X.

ADDITIONAL INFORMATION

If more than one screen,
show locations of each on sketch.