

WALTHALL

E76

7-29-70

7-29

date well completed

19

Fitzgerald well Co

firm name

Walthall

county well located

MISSISSIPPI BOARD OF WATER COMMISSIONERS 416 North State Street Jackson, Mississippi 39201

CODED

WATER WELL DRILLERS LOG

LANDOWNER:

Hattie Elzey

RR, Fulton, Miss. (mailing address)

description of formations encountered

from to

Red clay  
Red sand

0 20  
20 80

Red gravel  
Coarse sand & gravel

80 125  
125 142

WELL LOCATION:

sec 10 T 20 N R 10 E

IN miles of MESA (distance) (direction) (nearest town)

WELL PURPOSE: Home (home, irrigation, municipal, industrial)

WELL COMPLETION DATA:

- (1) diameter (inches) 4
(2) total depth (feet) 142
(3) static water level (feet) 100 below above top of ground.
(4) casing (material) (depth) 134
4 if telescope see back. (size)
(5) screen 8 134 (length) (depth to top)
4 (size) (material)
(6) pump 3/4 6 (HP) (yield gpm)
6 (type power)
(7) electric log (yes or no)
(organization running log)
(8) how well bottom plugged

CODED


AUG 17 1970

DRILLERS REMARKS:

MISS. BE. WATER

If well telescopes please sketch and show depths.

GROUND LEVEL

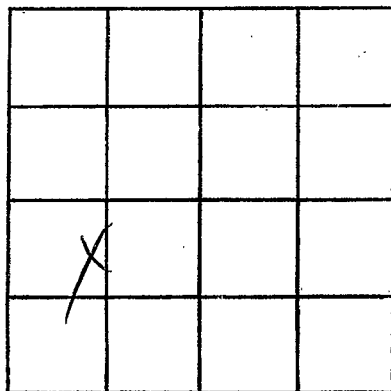

SECTION 10

Please indicate well location X.

ADDITIONAL INFORMATION

If more than one screen,  
show locations of each on sketch.