

WALTHALL
E 78
10-15-70

MISSISSIPPI
BOARD OF WATER COMMISSIONERS
416 North State Street
Jackson, Mississippi 39201

CODED

WATER WELL DRILLERS LOG

10-15 - 1970 Red Martin Water Well Walthall
date well completed firm name county well located


LANDOWNER:	description of formations encountered	from	to
<u>Mr Ollie P. Rushing</u> <u>Lyden Louisiana Miss RT 6</u> (mailing address)	<u>Top clay.</u>		<u>18</u>
WELL LOCATION: sec. <u>18</u> T. <u>20</u> S. R. <u>10</u> E. <u>4</u> miles (distance) miles <u>West</u> (direction) of <u>Lyden</u> (nearest town)	<u>Sand</u>	<u>18</u>	<u>90</u>
WELL PURPOSE: <u>home</u> (home, irrigation, municipal, industrial)	<u>1 foot Sand Rock</u>	<u>80</u>	<u>81</u>
WELL COMPLETION DATA:	<u>Sand</u>	<u>91</u>	<u>100</u>
(1) diameter (inches) <u>4" pvc</u> (2) total depth (feet) <u>100</u> (3) static water level (feet) <u>60</u> below above top of ground. (4) casing <u>pvc</u> <u>90</u> (material) (depth) (size) if telescope see back.	<p>CODED</p>		
(5) screen <u>10</u> <u>90</u> (length) (depth to top) <u>4 1/2" 12-gal</u> <u>40</u> (size) (material)			
(6) pump <u>1</u> <u>4</u> (HP) (yield gpm) <u>Elect</u> (type power)			
(7) electric log <u>no</u> (yes or no)			
(organization running log)			
(8) how well bottom plugged <u>Sand Rock. Each 2 ft</u>			
DRILLERS REMARKS: <u>This bore hole of sand rock was very tough</u>			

OCT 19 1970

MISS. BD. OF
WATER COMM.

If well telescopes please sketch and show depths.

GROUND LEVEL

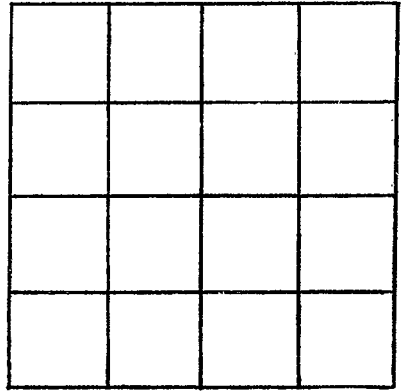

SECTION M&F-

Please indicate well location X.

ADDITIONAL INFORMATION

If more than one screen, show locations of each on sketch.