

Walthall
E 79
9-15-70

MISSISSIPPI
BOARD OF WATER COMMISSIONERS
416 North State Street
Jackson, Mississippi 39201

CODED

WATER WELL DRILLERS LOG

Sept 15, 1970 date well completed
Chester Keweenaw firm name
Walthall county well located

LANDOWNER: James Swamy
RFD -
Tylertown
(mailing address)

WELL LOCATION:
sec 20 T 20 N R 9 E
5 miles W of Tylertown
(distance) (direction) (nearest town)

WELL PURPOSE: Domestic
(home, irrigation, municipal, industrial)

WELL COMPLETION DATA:

- (1) diameter (inches) 4"
- (2) total depth (feet) 139
- (3) static water level (feet) 70 below top of ground
- (4) casing: Plastic Bottom (material) (depth)
- (5) screen: 6' length, 133' depth to top, 4" size, Plastic material
- (6) pump: 1/2 Sub 17 (HP), Elect (type power), (yield gpm)
- (7) electric log: No (yes or no)
- (organization running log)

(8) how well bottom plugged: wooden plug

DRILLERS REMARKS: old well had

| description of formations encountered | from | to |
|---------------------------------------|------|-----|
| Red Sandy clay | 0 | 12 |
| Red chalk | 12 | 32 |
| Sand & gravel | 32 | 68 |
| Red Silty Sand | 68 | 91 |
| Sand & gravel | 91 | 94 |
| White chalk | 94 | 114 |
| Red chalk & gravel | 114 | 125 |
| Coarse Sand & Gravel | 125 | 139 |


CODED

OCT 14 1970

MISS. BD. OF
WATER COMM.

If well telescopes please sketch and show depths.

GROUND LEVEL

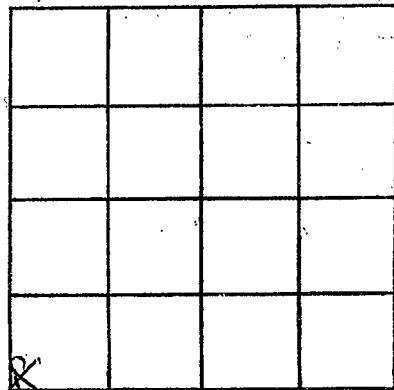

SECTION 20

Please indicate well location X.

ADDITIONAL INFORMATION

If more than one screen,
show locations of each on sketch.