

MISSISSIPPI
BOARD OF WATER COMMISSIONER
416 North State Street
Jackson, Mississippi 39201

CODED

WALTHALL
E 80
9-16-70

WATER WELL DRILLERS LOG

Sept 16 1970 date well completed
Chester James Walthall firm name
county well located

LANDOWNER: Allan
Cooker
PFD Tyler town
(mailing address)

description of formations encountered	from	to
Red Sandy clay	2	12
Sand & gravel	12	60
chalky sand & gravel	60	108
Red Sand	108	120
Gravel & Sand	120	133

WELL LOCATION:
sec. 20 T. 20 N. R. 10 E
5 miles W of Tyler town
(distance) (direction) (nearest town)

WELL PURPOSE:
Home (home, irrigation, municipal, industrial)

- WELL COMPLETION DATA:
- (1) diameter (inches) 4"
 - (2) total depth (feet) 133
 - (3) static water level (feet) 59 below top of ground
 - (4) casing Plastic Ballum (material) (depth)
 - (5) screen 6' 127 (length) (depth to top)
4" Plastic (size) (material)
 - (6) pump Super (type power) (yield gpm)
installing pump
 - (7) electric log No (yes or no)
 - (8) how well bottom plugged wooden plug

CODED


OCT 14 1970

DRILLERS REMARKS:
old 2" well pad

MISS. BD. OF
WATER COMMISSIONER

If well telescopes please sketch and show depths.

GROUND LEVEL

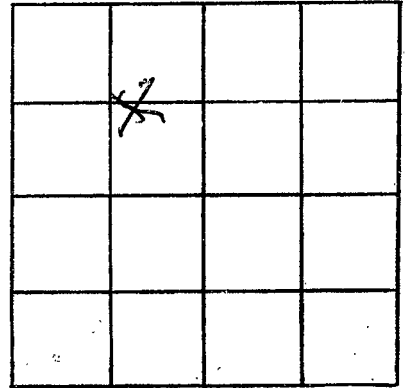

SECTION 20

Please indicate well location X.

ADDITIONAL INFORMATION

If more than one screen,
show locations of each on sketch.