

WALTHALL
E 81
9-16-70

MISSISSIPPI
 BOARD OF WATER COMMISSIONERS
 416 North State Street
 Jackson, Mississippi 39201

CODED

WATER WELL DRILLERS LOG

Sept 16 19 70 Flynn & Callahan Walthall
 date well completed firm name county well located

LANDOWNER:
Larry Stinson
R.R. Tylston, Miss.
 (mailing address)

description of formations encountered	from	to
<u>Red clay</u>	<u>0</u>	<u>25</u>
<u>Red sand</u>	<u>25</u>	<u>90</u>
<u>Coarse sand</u>	<u>90</u>	<u>108</u>

WELL LOCATION:
 sec. 35 T. 2 N. R. 10 E.
1 miles SW of Tylston
 (distance) (direction) (nearest town)

WELL PURPOSE: Home
 (home, irrigation, municipal, industrial)

- WELL COMPLETION DATA:
- (1) diameter (inches) 4
 - (2) total depth (feet) 108
 - (3) static water level (feet) 70 below above top of ground.
 - (4) casing plastic, 100,
 (material) (depth)
4 If telescope see back.
 (size)
 - (5) screen 8, 100
 (length) (depth to top)
4, plastic
 (size) (material)
 - (6) pump 1/2, 10
 (HP) (yield gpm)
Ele
 (type power)
 - (7) electric log no
 (yes or no)
 (organization running log)
 - (8) how well bottom plugged well

CODED


OCT 16 1970

DRILLERS REMARKS:

MISS. Bd. of
 WATER COMM.

If well telescopes please sketch and show depths.

GROUND LEVEL

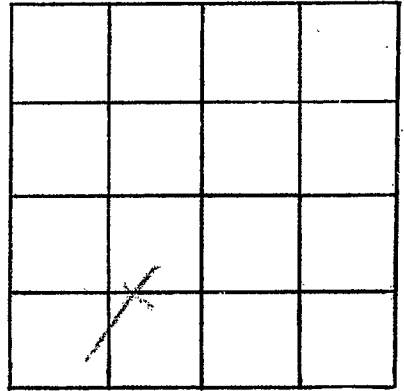

SECTION 2

Please indicate well location X.

ADDITIONAL INFORMATION

If more than one screen,
show locations of each on sketch.