

WALTHALL
E 82
10-1-70

MISSISSIPPI
BOARD OF WATER COMMISSIONERS
416 North State Street
Jackson, Mississippi 39201

CODED

WATER WELL DRILLERS LOG

Oct 1 1970 *Fitzgerald well* *Walthall*
date well completed from name county well located

LANDOWNER:
B. W. Johnson
B.R. Lyburn
(mailing address)

description of formations encountered	from	to
<i>fresh clay</i>	<i>0</i>	<i>20</i>
<i>Red sand</i>	<i>20</i>	<i>80</i>
<i>Red clay</i>	<i>80</i>	<i>120</i>
<i>Red sand</i>	<i>120</i>	<i>160</i>
<i>Coarse sand</i>	<i>160</i>	<i>175</i>

WELL LOCATION:
sec. *34* T *2N* R *10E*
3 miles *SW* of *Fulton*
(distance) (direction) (nearest town)

WELL PURPOSE: *Home*
(home, irrigation, municipal, industrial)

- WELL COMPLETION DATA:
- (1) diameter (inches) *4*
 - (2) total depth (feet) *175*
 - (3) static water level (feet) *85* below top of ground.
 - (4) casing *Plastic*, *169*,
(material) (depth)
4 if telescope see back.
(size)
 - (5) screen *6*, *169*
(length) (depth to top)
4, *Plastic*
(size) (material)
 - (6) pump _____
(HP) (yield gpm)
4
(type power)
 - (7) electric log *Yes*
(yes or no)
(organization running log)
 - (8) how well bottom plugged *wool py*

CODED


OCT 16 1970

DRILLERS REMARKS:

MISS. BD. OF
WATER COMMISSIONERS

If well telescopes please sketch and show depths.

GROUND LEVEL

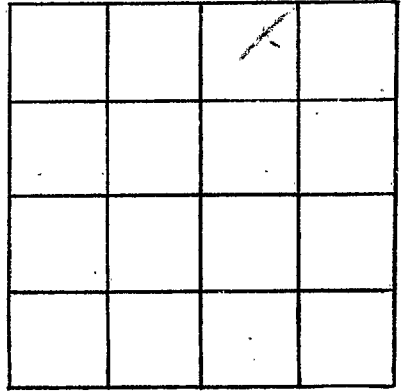

SECTION 34

Please indicate well location X.

ADDITIONAL INFORMATION

If more than one screen, show locations of each on sketch.