

WALTHALL
E84

9-25-70

MISSISSIPPI
BOARD OF WATER COMMISSIONERS
416 North State Street
Jackson, Mississippi 39201

CODED

WATER WELL DRILLERS LOG

Sept 25 1970 date well completed
Chester Keene Walthall firm name
Walthall county well located

LANDOWNER

description of formations encountered

from

to

Old Summer
RFD -
Tylertown -
(mailing address)

WELL LOCATION:

sec. 22 T. 2 N. R. 9 E.
6 1/2 miles W of Tylertown
(distance) (direction) (nearest town)

WELL PURPOSE:

Home -
(home, irrigation, municipal, industrial)

WELL COMPLETION DATA:

- (1) diameter (inches) 4"
- (2) total depth (feet) 141'
- (3) static water level (feet) broken above top of ground.
- (4) casing (material) Plastic Salton (depth)
- (5) screen (size) 6" (length) 135' (depth to top) Plastic (size) (material)
- (6) pump (HP) 1/2 HP installed by hand (type power)
- (7) electric log No (yes or no)

(organization running log)

(8) how well bottom plugged wood chips

DRILLERS REMARKS:

red 2 1/2 ft well clay

description of formations encountered	from	to
clay	0	16
Sand & gravel	16	20
white chalk	20	32
fine milky sand	32	130
extra coarse sand	130	141


CODED

NOV 12 1970

MISS. DEPT. OF
WATER CONTROL

If well telescopes please sketch and show depths.

GROUND LEVEL

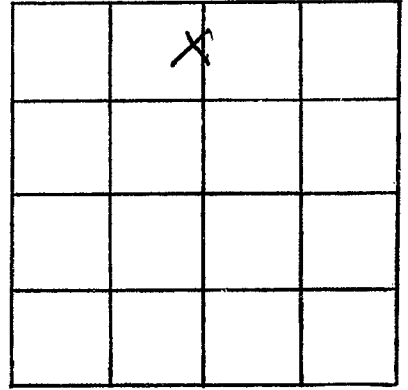

SECTION 25

Please indicate well location X.

ADDITIONAL INFORMATION

If more than one screen,
show locations of each on sketch.