

WALTHALL  
E 85  
11-2-70

MISSISSIPPI  
BOARD OF WATER COMMISSIONERS  
416 North State Street  
Jackson, Mississippi 39201

**CODED**

WATER WELL DRILLERS LOG

Nov. 2 1970 date well completed  
Chester Reeves firm name  
Walthall county well located

LANDOWNER: *D. V. Lang*  
*H-4-Tylertown*  
(mailing address)

description of formations encountered	from	to
<i>red clay</i>	<i>0</i>	<i>20</i>
<i>cherty gravel</i>	<i>20</i>	<i>40</i>
<i>sand &amp; gravel</i>	<i>40</i>	<i>70</i>
<i>gravel</i>	<i>70</i>	<i>87</i>

WELL LOCATION:  
sec. *15* T. *2* N R. *10* E  
*3* miles *W* of *Tylertown*  
(distance) (direction) (nearest town)

WELL PURPOSE: *farm*  
(home, irrigation, municipal, industrial)

- WELL COMPLETION DATA:
- (1) diameter (inches) *4"*
  - (2) total depth (feet) *87*
  - (3) static water level (feet) *59* below top of ground.
  - (4) casing *Plastic bottom*  
(material) (depth)
  - (size) if telescope see back.
  - (5) screen *6'* *81'*  
(length) (depth to top)
  - 4"* *Plastic*  
(size) (material)
  - (6) pump *old pump by owner*  
(HP) (yield gpm)
  - (type power)
  - (7) electric log *no*  
(yes or no)
  - (organization running log)

**CODED**


(8) how well bottom plugged *wasn't plugged*

DRILLERS REMARKS *old well log.*

NOV 16 1970

If well telescopes please sketch and show depths.

GROUND LEVEL

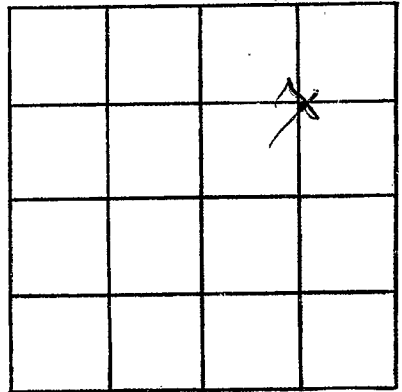

SECTION 15

Please indicate well location X.

ADDITIONAL INFORMATION

If more than one screen, show locations of each on sketch.