

E 87  
 Walthall  
 4-11-75

MISSISSIPPI  
 BOARD OF WATER COMMISSIONERS  
 416 North State Street  
 Jackson, Mississippi 39201

CODED

WATER WELL DRILLERS LOG

4-11 1975 Griner-Ginn Walthall  
 date well completed firm name county well located

LANDOWNER: Grant Thomas

description of formations encountered

from to

Re 5 Bot 185

Top Soil

0 1

Myrtle town  
 (mailing address)

Clay

1 62

Clay + Chalk

62 92

Sand

92 125

WELL LOCATION:

sec. 16 T. 2 N. R. 10 E  
Q3 miles W of Myrtle town  
 (distance) (direction) (nearest town)

WELL PURPOSE: home  
 (home, irrigation, municipal, industrial)

WELL COMPLETION DATA:

(1) diameter (inches) 2"  
 (2) total depth (feet) 125'  
 (3) static water level (feet) 60' below top of ground.

(4) casing Plastic 115'  
 (material) (depth)

2"  
 (size) if telescope see back.

(5) screen 10', 115'  
 (length) (depth to top)

2", Plastic  
 (size) (material)

(6) pump 1  
 (HP) (yield gpm)  
Electric  
 (type power)

(7) electric log             
 (yes or no)

            
 (organization running log)

(8) how well bottom plugged B.W. Valve


DECEMBER 1975  
 JUN 6 1975

DRILLERS REMARKS:

MISS. BD. OF WATER COMMISSIONERS

If well telescopes please sketch and show depths.

GROUND LEVEL

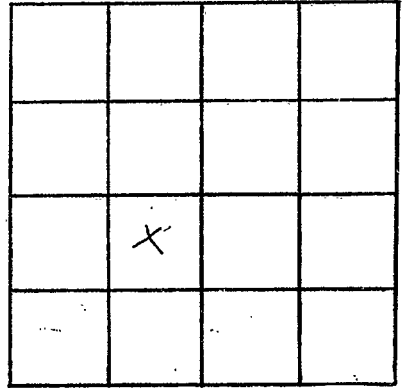

SECTION 16

Please indicate well location X.

ADDITIONAL INFORMATION

If more than one screen,  
show locations of each on sketch.