

WALTHALL
E 88
12-2-70

MISSISSIPPI
BOARD OF WATER COMMISSIONERS
416 North State Street
Jackson, Mississippi 39201

CODED

WATER WELL DRILLERS LOG

12-2 1970 Fitzgerald well Dr firm name Walthall county well located

LANDOWNER:
O. T. Hammond
P.O. Telephone Men.
(mailing address)

description of formations encountered	from	to
<u>Red Clay</u>	<u>2</u>	<u>8</u>
<u>River gravel</u>	<u>10</u>	<u>16</u>
<u>Fine sand</u>	<u>16</u>	<u>90</u>
<u>Coarse sand</u>	<u>90</u>	<u>100</u>

WELL LOCATION:
sec. 24 T. 2 N. R. 2 E. S. 2 W.
5 miles SW of Mesa
(distance) (direction) (nearest town)

WELL PURPOSE: Home
(home, irrigation, municipal, industrial)

WELL COMPLETION DATA:
(1) diameter (inches) 4
(2) total depth (feet) 100
(3) static water level (feet) 1 below above top of ground.
(4) casing Plastic 92
(material) (depth)
4 if telescope see back.
(size)
(5) screen 3 92
(length) (depth to top)
4 Plastic
(size) (material)
(6) pump 1 25
(HP) (yield gpm)
elec
(type power)
(7) electric log ny
(yes or no)
ny
(organization running log)

CODED

(8) how well bottom plugged Good


DEC 17 1970

DRILLERS REMARKS:

MISS. BD. OF
WATER COMMISSIONERS

If well telescopes please sketch and show depths.

GROUND LEVEL

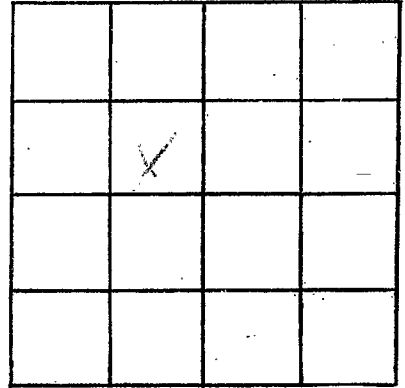

SECTION 24

Please indicate well location X.

ADDITIONAL INFORMATION

If more than one screen, show locations of each on sketch.