

WALTHALL
E 90
3-8-71

MISSISSIPPI
 BOARD OF WATER COMMISSIONERS
 416 North State Street
 Jackson, Mississippi 39201

CODED

WATER WELL DRILLERS LOG

3-8 1971 Fitzgerald Inc Walthall
 date well completed firm name county well located

LANDOWNER:
Hilton Stringer
 RR. Fylston, Miss.
 (mailing address)

WELL LOCATION:
 sec. 20 T. 2N R. 10E
5 miles W of Fylston
 (distance) (direction) (nearest town)

WELL PURPOSE:
Home
 (home, irrigation, municipal, industrial)

- WELL COMPLETION DATA:
- (1) diameter (inches) 4
 - (2) total depth (feet) 116.3
 - (3) static water level (feet) 100 below above top of ground.
 - (4) casing plastic, 155
 (material) (depth)
4 if telescope see back.
 (size)
 - (5) screen 8, 155
 (length) (depth to top)
4, plastic
 (size) (material)
 - (6) pump 1/2, 8
 (HP) (yield gpm)
66
 (type power)
 - (7) electric log no
 (yes or no)
 (organization running log)
 - (8) how well bottom plugged Washed

description of formations encountered	from	to
<u>Red clay</u>	<u>0</u>	<u>20</u>
<u>Red sand</u>	<u>20</u>	<u>80</u>
<u>Red gravel</u>	<u>80</u>	<u>100</u>
<u>Red sand</u>	<u>100</u>	<u>150</u>
<u>Coarse sand & gravel</u>	<u>150</u>	<u>113</u>


CODED

MAR 31 1971

DRILLERS REMARKS:

If well telescopes please sketch and show depths.

GROUND LEVEL

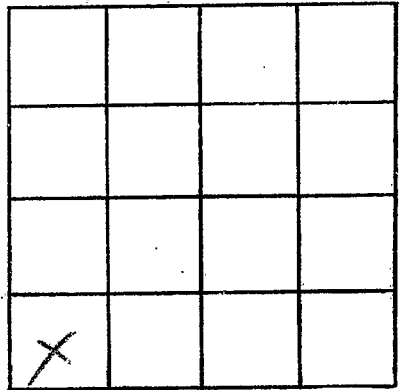

SECTION 70

Please indicate well location X.

ADDITIONAL INFORMATION

If more than one screen,
show locations of each on sketch.