

WALTHALL
E91
3-10-71

MISSISSIPPI
BOARD OF WATER COMMISSIONERS
416 North State Street
Jackson, Mississippi 39201

CODED

WATER WELL DRILLERS LOG

3-10
date well completed

1971 *Fitzgerald*
firm name

Walthall
county well located

LANDOWNER:
A. Sandifer
R.R. Teltown, Jr.
(mailing address)

WELL LOCATION:
sec. 9 T. 2N R. 10E
4 miles W of Teltown
(distance) (direction) (nearest town)

WELL PURPOSE:
Home
(home, irrigation, municipal, industrial)

- WELL COMPLETION DATA:
- (1) diameter (inches) 4
 - (2) total depth (feet) 138
 - (3) static water level (feet) 100 below above top of ground.
 - (4) casing galv. 132
(material) (depth)
4 if telescope see back.
(size)
 - (5) screen 6 132
(length) (depth to top)
4 galv.
(size) (material)
 - (6) pump 1/2 10
(HP) (yield gpm)
6 line
(type power)
 - (7) electric log no
(yes or no)
(organization running log)

description of formations encountered	from	to
<i>red clay</i>	<i>0</i>	<i>20</i>
<i>red sand</i>	<i>20</i>	<i>80</i>
<i>red gravel</i>	<i>80</i>	<i>110</i>
<i>course bit & gravel</i>	<i>110</i>	<i>138</i>

CODED


MAR 31 1971

DRILLERS REMARKS:

MISS. BD. OF
WATER COMMISSIONERS

If well telescopes please sketch and show depths.

GROUND LEVEL

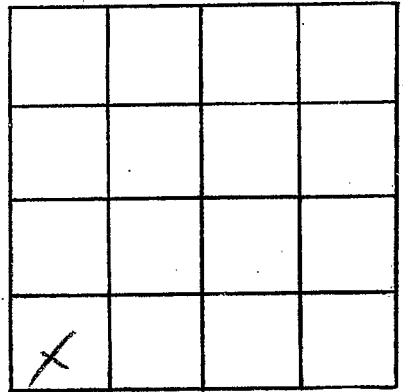

SECTION 9

Please indicate well location X.

ADDITIONAL INFORMATION

A series of horizontal lines for writing additional information, starting below the 'ADDITIONAL INFORMATION' header and extending down to the bottom of the page.

If more than one screen, show locations of each on sketch.