

WALTHALL  
E92  
3-11-71

MISSISSIPPI  
BOARD OF WATER COMMISSIONERS  
416 North State Street  
Jackson, Mississippi 39201

**CODED**

WATER WELL DRILLERS LOG

3-11 1971 *Flycatcher Well Dr* *Walthall*  
date well completed firm name county well located

LANDOWNER:

*J. A. Hawney*  
*H. R. Flycatcher Moss*  
(mailing address)

description of formations encountered

from to

<i>Red clay</i>	<i>0</i>	<i>20</i>
<i>Red silt</i>	<i>20</i>	<i>60</i>
<i>Red gravel</i>	<i>80</i>	<i>100</i>
<i>Crème Red &amp; grey</i>	<i>100</i>	<i>117</i>

WELL LOCATION:

sec. *11* T. *2N* R. *10E*  
*2* miles *N* of *Flycatcher*  
(distance) (direction) (nearest town)

WELL PURPOSE:

*Home*  
(home, irrigation, municipal, industrial)

WELL COMPLETION DATA:

- (1) diameter (inches) *4*
- (2) total depth (feet) *117*
- (3) static water level (feet) *70* below above top of ground.
- (4) casing *plastic*, *109*,  
(material) (depth)  
*4* if telescope see back.  
(size)
- (5) screen *3*, *109*  
(length) (depth to top)
- (6) pump *1/2*, *10*  
(HP) (yield gpm)  
*EL*  
(type power)
- (7) electric log *no*  
(yes or no)  
(organization running log)
- (8) how well bottom plugged *worky*


**CODED**

DRILLERS REMARKS:

MAD 31 1071

If well telescopes please sketch and show depths.

GROUND LEVEL

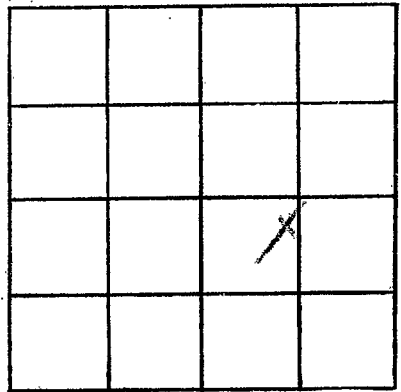

SECTION 11

Please indicate well location X.

ADDITIONAL INFORMATION

If more than one screen,  
show locations of each on sketch.