

WALTHALL
E 93
5-17-71

MISSISSIPPI
BOARD OF WATER COMMISSIONERS
416 North State Street
Jackson, Mississippi 39201

CODED

WATER WELL DRILLERS LOG

May 17 1971 R. Woodard Drilling Walthall
date well completed firm name county well located

LANDOWNER: Jodie B. Magel
Sylvestown, Miss.
(mailing address)

description of formations encountered	from	to
Red Clay	1	7
Sand & Gravel	7'	10.3

WELL LOCATION:
sec 23 T 2 N R 10 E
1 miles NW of Sylvestown
(distance) (direction) (nearest town)

WELL PURPOSE: Home
(home, irrigation, municipal, industrial)

- WELL COMPLETION DATA:
- diameter (inches) 4"
 - total depth (feet) 10.3
 - static water level (feet) 38 below top of ground.
 - casing Plastic, 88'
(material) (depth)
4" if telescope see back.
(size)
 - screen 15', 88'
(length) (depth to top)
4", Plastic
(size) (material)
 - pump 1, 2.5
(HP) (yield gpm)
230 AC
(type power)
 - electric log NO
(yes or no)
- (organization running log)
- (8) how well bottom plugged float type
BWV

CODED


MAY 21 1971

MISS. BD. OF
WATER COMM.

DRILLERS REMARKS:

If well telescopes please sketch and show depths.

GROUND LEVEL

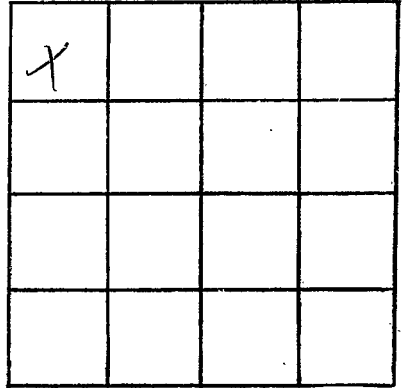

SECTION 23

Please indicate well location X.

ADDITIONAL INFORMATION

If more than one screen,
show locations of each on sketch.