

WALTHALL  
E 94  
4-14-71

MISSISSIPPI  
BOARD OF WATER COMMISSIONERS  
416 North State Street  
Jackson, Mississippi 39201

**CODED**

WATER WELL DRILLERS LOG

14 April 1971  
date well completed

Walthall  
firm name

county well located

LANDOWNER:

J. C. Lopez

Tylertown, Miss.  
(mailing address)

description of formations encountered

from

to

Clay	0	15
Clay Sand	15	25
Clay Sh	25	65
Charlton Rock	65	85
Sand Rock	85	108

WELL LOCATION:

sec. 15 T 2 N R 10 E  
S W  
2 miles West of Tylertown  
(distance) (direction) (nearest town)

WELL PURPOSE:

(home, irrigation, municipal, industrial)

WELL COMPLETION DATA:

- diameter (inches) 4
- total depth (feet) 108
- static water level (feet) 90 below top of ground.
- casing 8" (material), 102 (depth),  
(size) if telescope see back.
- screen 4" (length), 102 (depth to top),  
4" (size), 8" (material)
- pump 1/2 (HP), 8 (yield gpm),  
Electric (type power)
- electric log (yes or no)

(organization running log)

(8) how well bottom plugged Wood

**CODED**


MAY 21 1971

DRILLERS REMARKS:

MISS. BD. OF

If well telescopes please sketch and show depths.

GROUND LEVEL

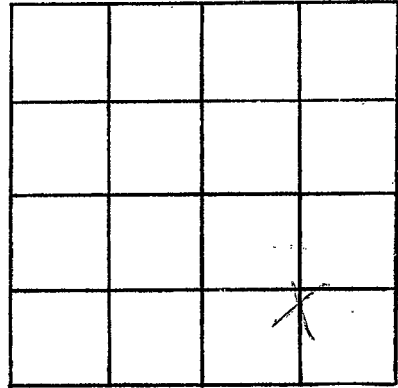

SECTION 15

Please indicate well location X.

ADDITIONAL INFORMATION

If more than one screen, show locations of each on sketch.