

WALTHALL

E95

6-22-71

MISSISSIPPI BOARD OF WATER COMMISSIONERS
416 North State Street
Jackson, Mississippi 39201

CODED

WATER WELL DRILLERS LOG

6-22

19

71 *Fitzgerald Well Serv.*

firm name

Walthall

county well located

LANDOWNER:

Seth Brumfield

R.R. Tylerton, Miss.
(mailing address)

description of formations encountered

from

to

<i>Red Clay</i>	0	20
<i>Red Sand</i>	20	70
<i>White Clay</i>	70	125
<i>Coarse Sand</i>	125	144

WELL LOCATION:

sec. 15 T. 2 N. R. 10 E. S. 5 W.

3 miles W of Tylerton
(distance) (direction) (nearest town)

WELL PURPOSE:

(home, irrigation, municipal, industrial)

WELL COMPLETION DATA:

- (1) diameter (inches) 4
- (2) total depth (feet) 144
- (3) static water level (feet) 80 below above top of ground.
- (4) casing plastic, 136 (material) (depth)
4 (size) if telescope see back.
- (5) screen 8, 136 (length) (depth to top)
4 (size) plastic (material)
- (6) pump 3/4, 14 (HP) (yield gpm)
elm (type power)
- (7) electric log no (yes or no)
(organization running log)
- (8) how well bottom plugged completely

CODED


JUN 22 1971

MISS. BD. OF WATER COMMISSIONERS

DRILLERS REMARKS:

If well telescopes please sketch and show depths.

GROUND LEVEL

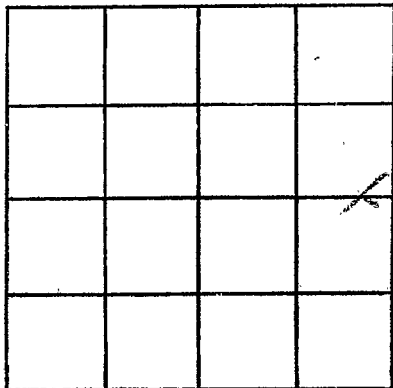

SECTION 15

Please indicate well location X.

ADDITIONAL INFORMATION

If more than one screen, show locations of each on sketch.