

WALTHALL
E-97
6-71

MISSISSIPPI
BOARD OF WATER COMMISSIONERS
416 North State Street
Jackson, Mississippi 39201

WATER WELL DRILLERS LOG

JUNE 19 71 E.B. SHERRARD WALTHALL
date well completed firm name well located

CODED

LANDOWNER:
T. C. STRINGER
Rt. 4 TYLERTOWN
(mailing address)

description of formations encountered	from	to
RED SAND & CLAY MIXED	0	90
GRAVEL & PEACH WITH SAND	90	165

WELL LOCATION:
sec 30 T. 2 S. R. 10 W.
6 miles W of TYLERTOWN
(distance) (direction) (nearest town)

WELL PURPOSE:
(Home, Irrigation, municipal, industrial)

- WELL COMPLETION DATA:
- (1) diameter (inches) 4"
 - (2) total depth (feet) 165
 - (3) static water level (feet) 90 below top of ground.
 - (4) casing PL, 155' (material) (depth)
4" (size) if telescope see back.
 - (5) screen 10' (length) (depth to top)
4" (size) PL (material)
 - (6) pump 3/4 (HP) 20 (yield gpm)
E (type power)
 - (7) electric log (yes or no) (no)
(organization running log)
 - (8) how well bottom plugged BWV

CODED


SEP 15 1971

DRILLERS REMARKS:

MISS. BD. OF
WATER COM.

If well telescopes please sketch and show depths.

GROUND LEVEL

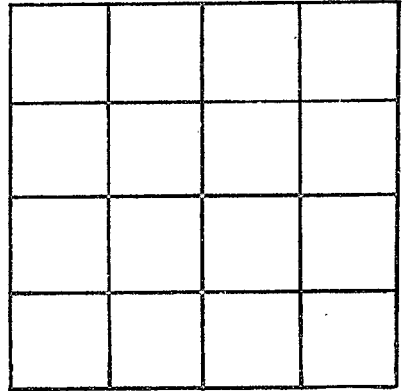

SECTION _____

Please indicate well location X.

ADDITIONAL INFORMATION

If more than one screen,
show locations of each on sketch.