

WALTHALL  
E-98  
7-71

MISSISSIPPI  
BOARD OF WATER COMMISSIONERS  
416 North State Street  
Jackson, Mississippi 39201

**CODED**

WATER WELL DRILLERS LOG

July 1971 E.B. SHERRARD WALTHALL  
date well completed firm name county well located

LANDOWNER:  
EASTERLING QUINN  
TYLERTOWN, Miss.  
(mailing address)

description of formations encountered	from	to
CLAY & GRAVEL	0	50'
STREAKS SAND		
CLAY	50	80'
GRAVEL & SAND	80	122'

WELL LOCATION:  
sec. 5 T 20 N R 10 E  
S W  
5 miles NW of TYLERTOWN  
(distance) (direction) (nearest town)

WELL PURPOSE:  
(home, irrigation, municipal, industrial)

- WELL COMPLETION DATA:
- (1) diameter (inches) 2"
  - (2) total depth (feet) 122
  - (3) static water level (feet) 70 below above top of ground.
  - (4) casing PL 65  
(material) (depth)  
2"  
(size) If telescope see back.
  - (5) screen 5'  
(length) (depth to top)  
2" PL  
(size) (material)
  - (6) pump 1 1/2 8  
(HP) (yield gpm)  
E  
(type power)
  - (7) electric log (yes or no) (no)  
  
(organization running log)
  - (8) how well bottom plugged BWV

**CODED**


SEP 15 1971

DRILLERS REMARKS:

MISS. BD OF  
WATER COMM.

If well telescopes please sketch and show depths.

GROUND LEVEL

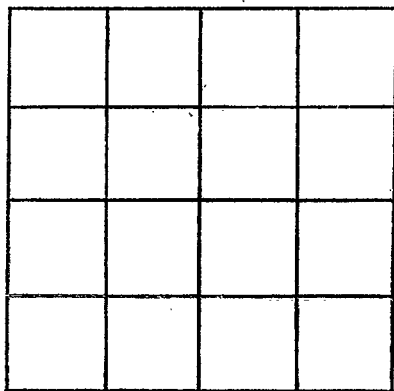

SECTION \_\_\_\_\_

Please indicate well location X.

ADDITIONAL INFORMATION

If more than one screen,  
show locations of each on sketch.