

WALTHALL

E-99

8-28-71

MISSISSIPPI BOARD OF WATER COMMISSIONERS
416 North State Street
Jackson, Mississippi 39201

WATER WELL DRILLERS LOG

CODED

8-28

date well completed

1971

Fitzgerald Well Dr

firm name

Walthall

county well located

LANDOWNER:

Jimmy Johnson

R.R. Tylton Miss.
(mailing address)

description of formations encountered

from

to

Red clay 0 24
Red sand 20 125
Coarse sand & gravel 125 137

WELL LOCATION:

sec. ~~10~~ T 2 N R 10 E

2 miles W of Tylton
(distance) (direction) (nearest town)

WELL PURPOSE:

Home
(home, irrigation, municipal, industrial)

WELL COMPLETION DATA:

- (1) diameter (inches) 4
- (2) total depth (feet) 137
- (3) static water level (feet) 65 below above top of ground.
- (4) casing plastic, 129,
(material) (depth)
4 If telescope see back.
(size)
- (5) screen 8, 129
(length) (depth to top)
4, plastic
(size) (material)
- (6) pump 1/2, 8
(HP) (yield gpm)
elec
(type power)
- (7) electric log ny
(yes or no)
(organization running log)
- (8) how well bottom plugged loosely

CODED


SEP 15 1971

DRILLERS REMARKS:

MISS. Bd. OF WATER COMMISSIONERS

If well telescopes please sketch and show depths.

GROUND LEVEL

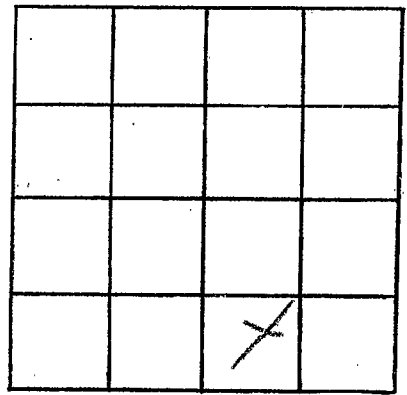

SECTION 10

Please indicate well location X.

ADDITIONAL INFORMATION

Lined area for additional information.

If more than one screen, show locations of each on sketch.