

**WALTHALL**  
**E-100**  
**8-31-71**

MISSISSIPPI  
 BOARD OF WATER COMMISSIONERS  
 416 North State Street  
 Jackson, Mississippi 39201

WATER WELL DRILLERS LOG

**CODED**

8-31  
 date well completed

1971 *Walthall Well Co*  
 firm name

*Walthall*  
 county well located

LANDOWNER:	description of formations encountered	from	to
<i>W.C. Smith</i>			
<i>R.R. Kerkens, Miss.</i> (mailing address)	<i>Red clay</i>	<i>0</i>	<i>20</i>
	<i>Red sand</i>	<i>20</i>	<i>90</i>
	<i>Consolidated gravel</i>	<i>90</i>	<i>102</i>
WELL LOCATION:			
sec. <i>15</i> T. <i>2</i> N. R. <i>10</i> E			
<i>2</i> miles <i>W</i> of <i>Yuletta</i> (distance) (direction) (nearest town)			
WELL PURPOSE:			
<i>Home</i> (home, irrigation, municipal, industrial)			
WELL COMPLETION DATA:			
(1) diameter (inches) <i>4</i>			
(2) total depth (feet) <i>102</i>			
(3) static water level (feet) <i>50</i> below above top of ground.			
(4) casing <i>Plastic</i> <i>94</i> (material) (depth)			
<i>4</i> (size) if telescope see back.			
(5) screen <i>8</i> <i>94</i> (length) (depth to top)			
<i>4</i> (size) <i>Plastic</i> (material)			
(6) pump <i>1</i> <i>15</i> (HP) (yield-gpm)			
<i>Adv</i> (type-power)			
(7) electric log <i>no</i> (yes or no)			
(organization-running log)			
(8) how well bottom-plugged <i>wool</i>			

**CODED**


SEP 15 1971

DRILLERS REMARKS:

MISS. DR. AS  
 STATE COMM  
 1971

If well telescopes please sketch and show depths.

GROUND LEVEL

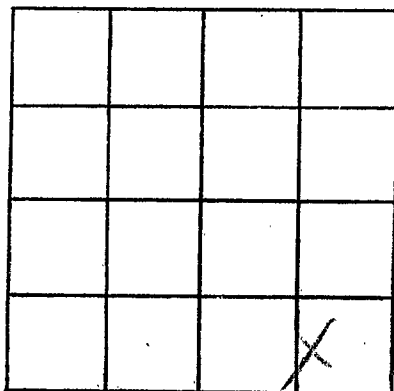

SECTION 15

Please indicate well location X.

ADDITIONAL INFORMATION

If more than one screen,  
show locations of each on sketch.