

MISSISSIPPI
BOARD OF WATER COMMISSIONERS
416 North State Street
Jackson, Mississippi 39201

CODED

WATER WELL DRILLERS LOG

WALTHALL
E 101
10-6-71

Oct. 6 1971 B. Woodward Drilling Walthall
date well completed firm name county well located

LANDOWNER: <u>W. Winton</u>	description of formations encountered	from	to
<u>Coron</u> <u>H. 4</u>			
<u>Zylertown, Miss.</u> (mailing address)	<u>Gravel</u>	<u>21</u>	<u>66'</u>
WELL LOCATION: sec. <u>15</u> T <u>2</u> N R <u>10</u> E <u>4</u> miles <u>West</u> of <u>Zylertown</u> (distance) (direction) (nearest town)	<u>Clay</u>	<u>66</u>	<u>70'</u>
	<u>Gravel</u>	<u>70</u>	<u>100'</u>
WELL PURPOSE: <u>Home</u> (home, irrigation, municipal, industrial)			
WELL COMPLETION DATA:			
(1) diameter (inches) <u>4</u>			
(2) total depth (feet) <u>100</u>			
(3) static water level (feet) <u>80</u> below top of ground. above			
(4) casing <u>Plastic</u> , <u>90'</u> (material) (depth) <u>4"</u> (size) If telescope see back.			
(5) screen <u>10'</u> , <u>90'</u> (length) (depth to top) <u>4"</u> , <u>Plastic</u> (size) (material)			
(6) pump <u>1/2</u> , <u>12</u> (HP) (yield gpm) <u>115V AC</u> (type power)			
(7) electric log <u>NO</u> (yes or no)			
(organization running log)			
(8) how well bottom plugged <u>Float</u> <u>Type B&V</u>			
DRILLERS REMARKS:			


CODED

OCT 18 1971

MISS. BD. OF
WATER COMMISSIONERS

If well telescopes please sketch and show depths.

GROUND LEVEL

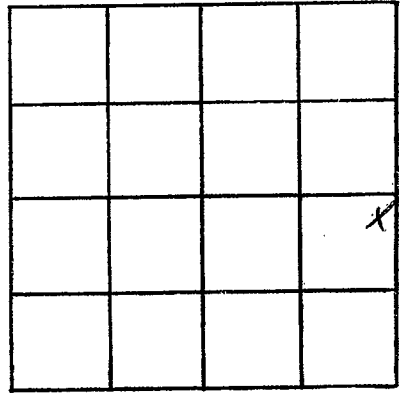

SECTION 15

Please indicate well location X.

ADDITIONAL INFORMATION

If more than one screen,
show locations of each on sketch.

20
15
10
5