

Walthall
E 105
11-14-71

MISSISSIPPI
 BOARD OF WATER COMMISSIONERS
 416 North State Street
 Jackson, Mississippi 39201

CODED

WATER WELL DRILLERS LOG

11-4 1971 F. J. Gaudin & Co. Walthall
 date well completed firm name county well located


LANDOWNER:	description of formations encountered	from	to
<u>Buddy Carson</u>			
<u>R.R. Tyleton, Miss.</u> (mailing address)	<u>Red Clay</u> <u>Red sand & gravel</u> <u>Coarse sand & gravel</u>	<u>0</u> <u>20</u> <u>120</u>	<u>20</u> <u>120</u> <u>138</u>
WELL LOCATION:			
sec. <u>5</u> T. <u>2</u> N. R. <u>16</u> E. <u>6</u> miles <u>W</u> of <u>Tyleton</u> (distance) (direction) (nearest town)			
WELL PURPOSE: (home, irrigation, municipal, industrial)			
WELL COMPLETION DATA:			
(1) diameter (inches) <u>4</u>			
(2) total depth (feet) <u>139'</u>			
(3) static water level (feet) <u>110</u> below above top of ground.			
(4) casing <u>Plastic</u> , <u>131</u> (material) (depth) <u>4</u> if telescope see back. (size)			
(5) screen <u>8</u> , <u>131</u> (length) (depth to top)			
(6) pump <u>4</u> , <u>Plastic</u> (size) (material)			
(7) pump <u>1/2</u> , <u>8</u> (HP) (yield gpm)			
<u>Electric</u> (type power)			
(7) electric log <u>74</u> (yes or no)			
(organization running log)			
(8) how well bottom plugged <u>wood peg</u>			
DRILLERS REMARKS:			

NOV 29 1971



If well telescopes please sketch and show depths.

GROUND LEVEL

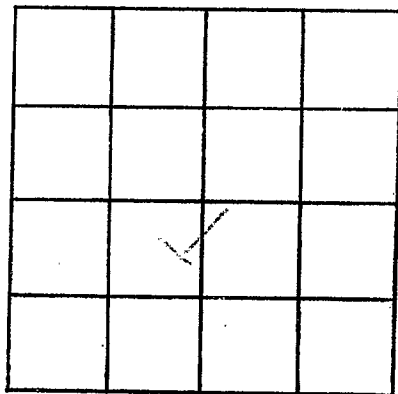

SECTION 5

Please indicate well location X.

ADDITIONAL INFORMATION

If more than one screen, show locations of each on sketch.