

**WALTHALL**  
**E 110**  
**6-7-72**

MISSISSIPPI  
 BOARD OF WATER COMMISSIONERS  
 416 North State Street  
 Jackson, Mississippi 39201

WATER WELL DRILLERS LOG **CODED**

6-7 19 72 Walthall Walthall  
 date well completed firm name county well located

LANDOWNER:	description of formations encountered	from	to
<u>Edward McLean -</u> <u>R.R. Glendon Jones</u> (mailing address)	<u>Red clay</u> <u>Red granite</u> <u>Coarse sandstone</u>	<u>0</u> <u>20</u> <u>140</u>	<u>20</u> <u>140</u> <u>152</u>
<b>WELL LOCATION:</b>			
sec. <u>2</u> T <u>N</u> R <u>10</u> E <u>5</u> miles <u>W</u> of <u>Lytle</u> (distance) (direction) (nearest town)			
<b>WELL PURPOSE:</b> (home, irrigation, municipal, industrial)			
<b>WELL COMPLETION DATA:</b>			
(1) diameter (inches) <u>4</u>			
(2) total depth (feet) <u>152</u>			
(3) static water level (feet) <u>110</u> below above top of ground.			
(4) casing <u>plastic</u> <u>144</u> (material) (depth)			
<u>4</u> if telescope see back. (size)			
(5) screen <u>8</u> <u>144</u> (length) (depth to top)			
<u>4</u> <u>plastic</u> (size) (material)			
(6) pump <u>1/2</u> <u>8</u> (HP) (yield gpm)			
<u>elec</u> (type power)			
(7) electric log <u>no</u> (yes or no)			
(organization running log)			
(8) how well bottom plugged <u>lined</u>			
<b>DRILLERS REMARKS:</b>			


**CODED**

RECEIVED  
 JUN 12 1972

MISS. BD. OF  
 WATER COM.

If well telescopes please sketch and show depths.

GROUND LEVEL

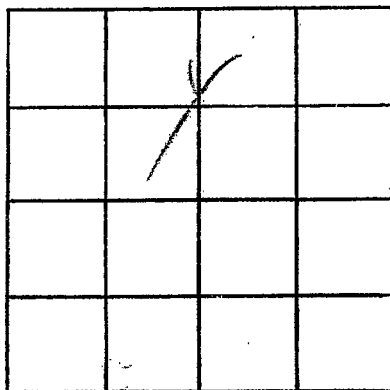

SECTION 6

Please indicate well location X.

ADDITIONAL INFORMATION

If more than one screen,  
show locations of each on sketch.