

WALTHALL
E 111
4-29-72

MISSISSIPPI
BOARD OF WATER COMMISSIONERS
416 North State Street
Jackson, Mississippi 39201

WATER WELL DRILLERS LOG

April 29 1972 Chester Keener unithall-
date well completed firm name county well located

LANDOWNER: Bill Walthall
APD - Tylahoma
(mailing address)

WELL LOCATION:
sec. 36 T 2 N R 9 E
6 1/2 miles WSW of Tylahoma
(distance) (direction) (nearest town)

WELL PURPOSE: Home
(home, irrigation, municipal, industrial)

WELL COMPLETION DATA:
(1) diameter (inches) 4"
(2) total depth (feet) 74'
(3) static water level (feet) 10 below top of ground
(4) casing: Plast. bottom (material) (depth)
if telescope see back.
(5) screen: 6' (length) 68' (depth to top)
4" (size) Plast. (material)
(6) pump: Old Pump (HP) (yield gpm)
Plast. (type power)
(7) electric log: No (yes or no)
(organization running log)

description of formations encountered	from	to
Red Sandy clay	0	12
Brown gravel and sand	12	36
Sandy sand	36	68
Red gravel sand	68	74
well plugged on sand rock.		


(8) how well bottom plugged? Goodly
DRILLERS REMARKS: The well had to be abandoned

JUN 30 1972

MISS. DIV. OF
WATER CONTROL

If well telescopes please sketch and show depths.

GROUND LEVEL

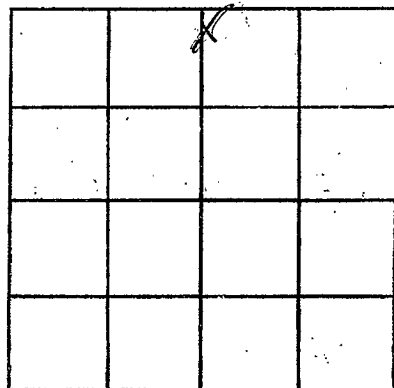

SECTION 36

Please indicate well location X.

ADDITIONAL INFORMATION

If more than one screen, show locations of each on sketch.