

WALTHALL
E 113
10-12-72

MISSISSIPPI
BOARD OF WATER COMMISSIONERS
416 North State Street
Jackson, Mississippi 39201

WATER WELL DRILLERS LOG

10-12 1972 Figurel well Walthall
date well completed firm name county well located

LANDOWNER:
Dr. J. Crawford
P.R. Tylston Miss.
(mailing address)

description of formations encountered	from	to
<u>Red clay</u>	<u>0</u>	<u>20</u>
<u>Red shell</u>	<u>20</u>	<u>60</u>
<u>White clay</u>	<u>60</u>	<u>120</u>
<u>Coarse sand</u>	<u>120</u>	<u>134</u>

WELL LOCATION:
sec. 19T 2N R 10E
5 miles N of Figurel
(distance) (direction) (nearest town)

WELL PURPOSE:
(home, irrigation, municipal, industrial)

WELL COMPLETION DATA:

- (1) diameter (inches) 4
- (2) total depth (feet) 134
- (3) static water level (feet) 80 below top of ground.
- (4) casing plastic, 126,
(material) (depth)
4 if telescope see back.
(size)
- (5) screen 8, 126
(length) (depth to top)
4, plastic
(size) (material)
- (6) pump 1/2 10
(HP) (yield gpm)
elm
(type power)
- (7) electric log no
(yes or no)
(organization running log)
- (8) how well bottom plugged lined


DRILLERS REMARKS:

OCT 17 1972

MISSISSIPPI
BOARD OF WATER COMMISSIONERS
JACKSON, MISSISSIPPI

If well telescopes please sketch and show depths.

GROUND LEVEL

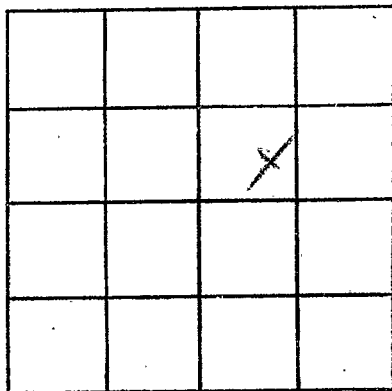

SECTION 19

Please indicate well location X.

ADDITIONAL INFORMATION

If more than one screen,
show locations of each on sketch.