

WALTHALL  
E 114  
7-20-72

MISSISSIPPI  
BOARD OF WATER COMMISSIONERS  
416 North State Street  
Jackson, Mississippi 39201

WATER WELL DRILLERS LOG **CODED**  
July 20 1972 Chester Reeves Walthall  
date well completed firm name county well located

LANDOWNER: John Meadows  
RFD.  
Telephons  
(mailing address)

description of formations encountered	from	to
Clay	0	10
Sand	10	40
Red chalk	40	60
Chalky Sand	60	90
Sand	90	110
Gravel	110	124

WELL LOCATION:  
sec. 23 T. 2 N R. 10 E  
1/4 miles ENE of Walthall  
(distance) (direction) (nearest town)

WELL PURPOSE: Same  
(home, irrigation, municipal, industrial)

WELL COMPLETION DATA:

(1) diameter (inches) 14"

(2) total depth (feet) 120'

(3) static water level (feet) 66' below top of ground.

(4) casing 12" cast, galv. (material) (depth)

(size) if telescope see back.

(5) screen 6' length, 17' depth to top  
1/2" cast (size) (material)

(6) pump 1/2 HP (HP) 17 (yield gpm)  
steel (type power)

(7) electric log no (yes or no)

(organization running log)

**CODED**


(8) how well bottom plugged  
wooden plug

DRILLERS REMARKS:  
old 2" well bad.

NFC 1 1972

If well telescopes please sketch and show depths.

GROUND LEVEL

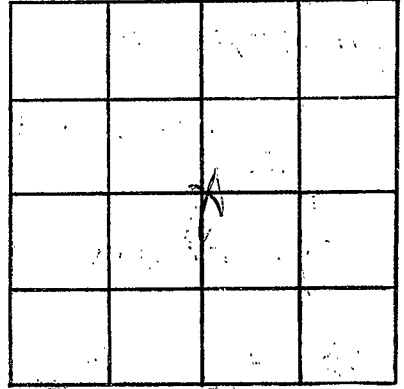

SECTION 13

Please indicate well location X.

ADDITIONAL INFORMATION

If more than one screen, show locations of each on sketch.