

WALTHALL
E 116
10-4-72

MISSISSIPPI
BOARD OF WATER COMMISSIONERS
416 North State Street
Jackson, Mississippi 39201

CODED

WATER WELL DRILLERS LOG

0 of 4 1972 Chester Keener Walthall
date well completed firm name county well located

LANDOWNER: Henry Lang
110-1/2 Johnson
(mailing address)

WELL LOCATION:
sec. 12 T. 2 N R. 10 E
1 1/2 miles NE of Johnson
(distance) (direction) (nearest town)

WELL PURPOSE: same
(home, irrigation, municipal, industrial)

WELL COMPLETION DATA:

- (1) diameter (inches) 4"
- (2) total depth (feet) 120
- (3) static water level (feet) 6.3 below top of ground. above
- (4) casing Plastic Balltown
(material) (depth)
 If telescope see back.
(size)
- (5) screen 6' 1 1/4'
(length) (depth to top)
1/4" plastic
(size) (material)
- (6) pump 1/2 HP 12
(HP) (yield gpm)
elect
(type power)
- (7) electric log no
(yes or no)
HR
(organization running log)
- (8) how well bottom plugged wooden plug

description of formations encountered	from to	
Red clay	0	20
sand	20	33
pink chalk	33	65
Sand & gravel	65	71
Red chalk	71	94
coarse sand	94	120

CODED


DRILLERS REMARKS:
New Treater
facation

DEC 4 1972

MISS. OF
WATER COMM.

If well telescopes please sketch and show depths.

GROUND LEVEL

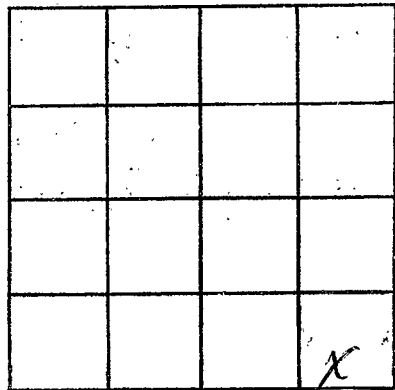

SECTION 10

Please indicate well location X.

ADDITIONAL INFORMATION

If more than one screen,
show locations of each on sketch.