

WALTHALL

E117

11-1-72

MISSISSIPPI
 BOARD OF WATER COMMISSIONERS
 416 North State Street
 Jackson, Mississippi 39201

WATER WELL DRILLERS LOG

CODED

11-1

1972

Fitzgerald

Walthall

date well completed

firm name

county well located

LANDOWNER:

Bob Lorde

description of formations encountered

from

to

R.R. Lytle
(mailing address)

<i>Red clay</i>	<i>7</i>	<i>10</i>
<i>Red sand</i>	<i>10</i>	<i>20</i>
<i>Coarse sand</i>	<i>20</i>	<i>78</i>

WELL LOCATION:

sec. 11 T. 2 N. R. 10 E.
S *W*
2 miles WNW of Lytle
 (distance) (direction) (nearest town)

WELL PURPOSE:

Home
(home, irrigation, municipal, industrial)

WELL COMPLETION DATA:

- (1) diameter (inches) 4
- (2) total depth (feet) 78
- (3) static water level (feet) 20 below above top of ground.
- (4) casing plastic, 90,
(material) (depth),
4 if telescope see back.
(size)
- (5) screen 8, 90,
(length) (depth to top)
4, plastic
(size) (material)
- (6) pump 1/2, 12,
(HP) (yield gpm)
elm
(type power)
- (7) electric log yes
(yes or no)
(organization running log)
- (8) how well bottom plugged unplugged

CODED


DRILLERS REMARKS:

DEC 7 1972

MISSISSIPPI BOARD OF WATER COMMISSIONERS

If well telescopes please sketch and show depths.

GROUND LEVEL

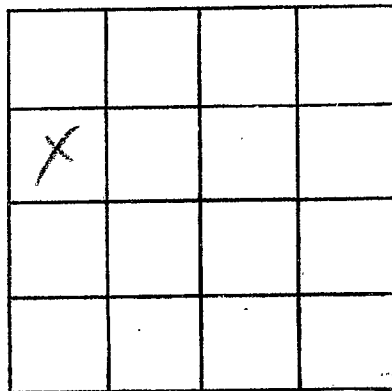

SECTION 11

Please indicate well location X.

ADDITIONAL INFORMATION

If more than one screen,
show locations of each on sketch.