

WALTHALL
 E 118
 1-4-73

MISSISSIPPI
 BOARD OF WATER COMMISSIONERS
 416 North State Street
 Jackson, Mississippi 39201

VOID

WATER WELL DRILLERS LOG

1-4 date well completed 19 73 firm name F. Z. ... well county well located Walthall

LANDOWNER:

description of formations encountered

from

to

Deevey Martin

R.R. Tylston
 (mailing address)

<u>Red clay</u>	<u>0</u>	<u>20</u>
<u>Red loess + ground</u>	<u>20</u>	<u>145</u>
<u>Coarse sand</u>	<u>145</u>	<u>165</u>

WELL LOCATION:

sec. 30 T. 2 N R. 10 E
4 miles W of Tylston
 (distance) (direction) (nearest town)

WELL PURPOSE:

(home, irrigation, municipal, industrial) Home

WELL COMPLETION DATA:

- diameter (inches) 4
- total depth (feet) 163
- static water level (feet) 95 below above top of ground.
- casing plastic, 155,
 (material) (depth)
4 if telescope see back.
 (size)
- screen 8, 155
 (length) (depth to top)
4, plastic
 (size) (material)
- pump 3/4 15
 (HP) (yield gpm)
elec
 (type power)
- electric log no
 (yes or no)
- organization running log _____
- how well bottom plugged woody


VOID

JAN 20 1973

DRILLERS REMARKS:

If well telescopes please sketch and show depths.

GROUND LEVEL

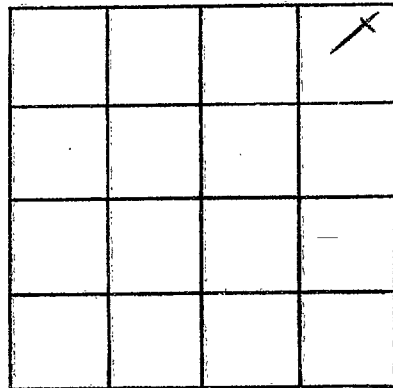

SECTION 30

Please indicate well location X.

ADDITIONAL INFORMATION

If more than one screen,
show locations of each on sketch.