

WALTHALL

E 119

1-15-73

MISSISSIPPI BOARD OF WATER COMMISSIONERS 416 North State Street Jackson, Mississippi 39201

WATER WELL DRILLERS LOG

CODED

15 Jan 1973 date well completed

J.T. Crawford firm name

Walthall county well located

LANDOWNER:

Eugene Bushong Testetown

(mailing address)

description of formations encountered

from

to

Clay 0 10
Red Silty clay 10 35
Sand 35 70
Red Rock 70 85
Sand 85 136

WELL LOCATION:

sec. 23 T 2 N R 10 E S W 3 miles W of Testetown (distance) (direction) (nearest town)

WELL PURPOSE:

(home, irrigation, municipal, industrial)

WELL COMPLETION DATA:

- (1) diameter (inches) 4
(2) total depth (feet) 136
(3) static water level (feet) 70 below top of ground.
(4) casing (material) PI (depth) 130
(size) if telescope see back.
(5) screen (length) 6 (depth to top) 130
(size) 4 (material) PI
(6) pump (HP) 1/2 (yield gpm) 8
(type power) electric
(7) electric log (yes or no)

CODED


(organization running log)

(8) how well bottom plugged unplug

DRILLERS REMARKS:

If well telescopes please sketch and show depths.

GROUND LEVEL

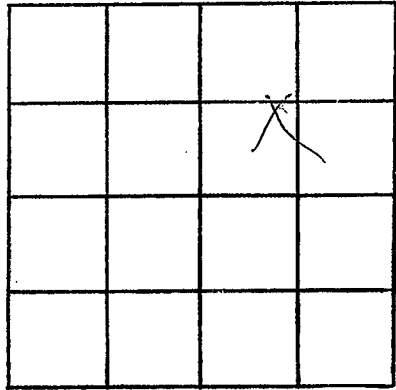

SECTION 23

Please indicate well location X.

ADDITIONAL INFORMATION

If more than one screen,
show locations of each on sketch.