

WALTHALL
E 120
2-15-73

MISSISSIPPI
BOARD OF WATER COMMISSIONERS
416 North State Street
Jackson, Mississippi 39201

CODED

WATER WELL DRILLERS LOG

Feb 15 1973 date well completed
Chester Reeves firm name
Walthall county well located

LANDOWNER	description of formations encountered	from	to
Sylvester Jordan	Red clay	0	18
RFD - Tylertown (mailing address)	Red sand	18	52
	Small gravel & sand	52	61
	Coarse sand & open gravel	61	98
		98	115

WELL LOCATION:
sec. 31 T. 2 N. R. 10 E.
4 1/2 miles WSW of Tylertown (distance) (direction) (nearest town)

WELL PURPOSE: house (home, irrigation, municipal, industrial)

- WELL COMPLETION DATA:
- (1) diameter (inches) 4"
 - (2) total depth (feet) 115
 - (3) static water level (feet) 86 below top of ground.
 - (4) casing Plast. bottom (material) (depth)
 - _____ if telescope see back. (size)
 - (5) screen 6' (length) 109 (depth to top)
2" (size) Plast (material)
 - (6) pump 1/2 Sub (HP) 15 (yield gpm)
Electric (type power)
 - (7) electric log No (yes or no)
 - _____ (organization running log)
 - (8) how well bottom plugged wooden plug


CODED

APR 9 1973

DRILLERS REMARKS:
New house

If well telescopes please sketch and show depths.

GROUND LEVEL

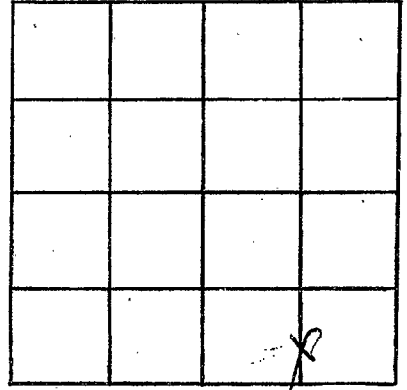

SECTION 31

Please indicate well location X.

ADDITIONAL INFORMATION

If more than one screen,
show locations of each on sketch.