

CODED

MISSISSIPPI
BOARD OF WATER COMMISSIONERS
416 North State Street
Jackson, Mississippi 39201

WALTHALL
E 121
3-6-73

WATER WELL DRILLERS LOG

March 6 1973 Chestnut Keewee Walthall
date well completed firm name county well located

LANDOWNER:

Al Leggett
Tylertown

(mailing address)

description of formations encountered

from to

<u>Red clay</u>	<u>0</u>	<u>17</u>
<u>Red sand</u>	<u>17</u>	<u>66</u>
<u>Small gravel sand</u>	<u>66</u>	<u>78</u>
<u>chalky sand</u>	<u>78</u>	<u>114</u>
<u>Small gravel sand</u>	<u>114</u>	<u>125</u>

WELL LOCATION:

sec. 11 T. 2 N R. 10 E
3 miles (distance) SW of Tylertown (direction) (nearest town)

WELL PURPOSE: house
(home, irrigation, municipal, industrial)

WELL COMPLETION DATA:

- (1) diameter (inches) 4"
- (2) total depth (feet) 125
- (3) static water level (feet) 73 below top of ground.
- (4) casing Plast Biltone (material) (depth)

_____ if telescope see back.
(size)

- (5) screen 6' (length) 119' (depth to top)
- 4" (size) Plast (material)

- (6) pump Bay others (type) (yield gpm)
- _____ (type power)

- (7) electric log No (yes or no)

_____ (organization running log)

- (8) how well bottom plugged Chockin Plug

DRILLERS REMARKS:

old well hole

CODED


APR 2 1973

MISS. D.D. 67

MADE IN MISSISSIPPI

If well telescopes please sketch and show depths.

GROUND LEVEL

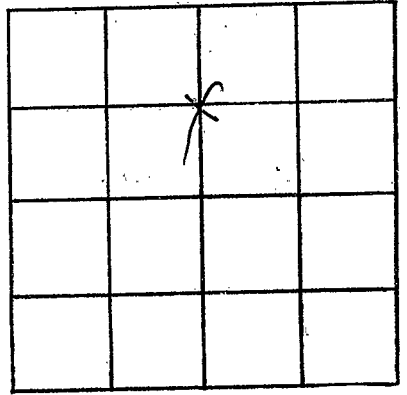

SECTION 11

Please indicate well location X.

ADDITIONAL INFORMATION

If more than one screen, show locations of each on sketch.