

CODED

MISSISSIPPI
BOARD OF WATER COMMISSIONERS
416 North State Street
Jackson, Mississippi 39201

WALTHALL
E 122
4-2-73

WATER WELL DRILLERS LOG


~~4-2~~ - 1973 *19* Easley Stafford Water well Service Walthall
date well completed firm name county well located

LANDOWNER: <u>John J. Holmes</u>	description of formations encountered	from	to
<u>Tylertown Miss.</u> (mailing address)	<u>Top soil & clay</u>	<u>0</u>	<u>18</u>
	<u>sand</u>	<u>18</u>	<u>32</u>
WELL LOCATION: sec. <u>30</u> T <u>2</u> N R <u>10</u> E S	<u>Chalk</u>	<u>32</u>	<u>110</u>
<u>city limit</u> miles <u>1/2</u> of <u>Tylertown</u> (distance) (direction) (nearest town)	<u>Sand & Gravel</u>	<u>110</u>	<u>148</u>
WELL PURPOSE: <u>home</u> (home, irrigation, municipal, industrial)			
WELL COMPLETION DATA:			
(1) diameter (inches) <u>4</u>			
(2) total depth (feet) <u>148</u>			
(3) static water level (feet) <u>10</u> below top of ground.			
(4) casing <u>Plastic</u> <u>128</u> (material) (depth)			
<u>4</u> If telescope see back. (size)			
(5) screen <u>20</u> <u>128</u> (length) (depth to top)			
<u>4 in.</u> <u>Plastic</u> (size) (material)			
(6) pump <u>Flow well</u> (HP) <u>2" flow</u> (yield gpm)			
(type power)			
(7) electric log (yes or no)			
(organization running log)			
(8) how well bottom plugged <u>B. W. V.</u>			
DRILLERS REMARKS: <u>Cleve Duncan</u>			

CODED

If well telescopes please sketch and show depths.

GROUND LEVEL

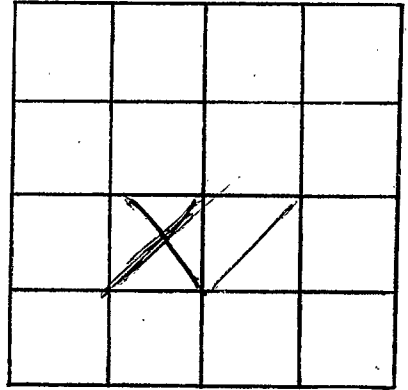

SECTION _____

Please indicate well location X.

ADDITIONAL INFORMATION

If more than one screen,
show locations of each on sketch.