

WALTHALL
E 123
2-13-73

MISSISSIPPI
BOARD OF WATER COMMISSIONERS
416 North State Street
Jackson, Mississippi 39201

CODED

WATER WELL DRILLERS LOG

Feb 13 1973 date well completed
chester keener firm name
walthall county well located

LANDOWNER: J. Keener
Del
PFD - Tylertown
(mailing address)

WELL LOCATION:
sec. 22 T. 2 N. R. 10 E.
2 1/2 miles (distance) W (direction) Tylertown (nearest town)

WELL PURPOSE: Home
(home, irrigation, municipal, industrial)

WELL COMPLETION DATA:

(1) diameter (inches) 4 1/2"
(2) total depth (feet) 105
(3) static water level (feet) _____ below/above top of ground.
(4) casing Plast. Bottom (material) (depth)
_____ if telescope see back. (size)
(5) screen 6' (length) 99' (depth, to top)
4" (size) Plast (material)
(6) pump 1/2 HP (HP) 15 (yield gpm)
elect (type power)
(7) electric log NO (yes or no)

(organization running log)

(8) how well bottom plugged
wooden plug

DRILLERS REMARKS:
New bore

description of formations encountered	from	to
Red clay	00	16
Red sand	16	55
Sand & small gravel	55	62
Chalky Lohcky	62	96
Red gravel & sand	96	105


CODED

JUN 5 1973

MISSISSIPPI BOARD OF WATER COMMISSIONERS

If well telescopes please sketch and show depths.

GROUND LEVEL

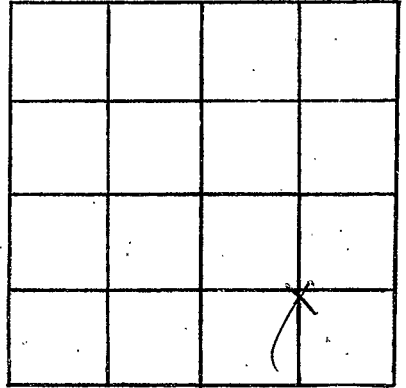

SECTION 22

Please indicate well location X.

ADDITIONAL INFORMATION

If more than one screen,
show locations of each on sketch.