

WALTHALL
E 124
8-3-73

MISSISSIPPI
BOARD OF WATER COMMISSIONERS
416 North State Street
Jackson, Mississippi 39201

CODED

WATER WELL DRILLERS LOG

8-3-73
date well completed

Essley Staffed Waterwell Drilling
firm name

Walthall
county well located

LANDOWNER: Loyce Robinson
Rt-3
Tylertown Miss
(mailing address)

description of formations encountered	from	to
Top soil	0	16
Chalk	16	40
Sand	40	80
Sand & Gravel	80	120
Chalk	120	138
Sand & Gravel	138	170

WELL LOCATION:
sec. 23 T. 2 N R. 10 E
10 miles West of Tylertown
(distance) (direction) (nearest town)

WELL PURPOSE:
(home, irrigation, municipal, industrial)

WELL COMPLETION DATA:

(1) diameter (inches) 4

(2) total depth (feet) 170

(3) static water level (feet) 6 below above top of ground.

(4) casing 4 150
(material) (depth)
4 if telescope see back.
(size)

(5) screen 20 150
(length) (depth to top)
4 Plastic
(size) (material)

(6) pump 1 HP 20
(HP) (yield gpm)
Elec.
(type power)

(7) electric log NO
(yes or no)

(organization running log)

(8) how well bottom plugged B.W.V.


CODED

DRILLERS REMARKS:
Gene Duncan

AUG 3 1973

If well telescopes please sketch and show depths.

GROUND LEVEL

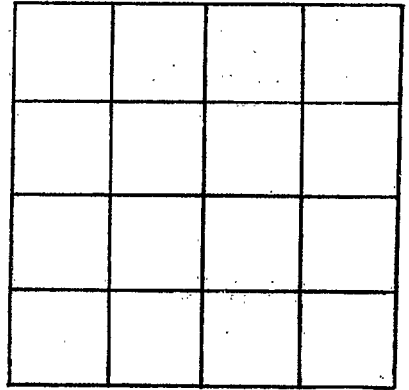

SECTION _____

Please indicate well location X.

ADDITIONAL INFORMATION

If more than one screen,
show locations of each on sketch.