

WALTHALL  
E 125  
8-27-73

MISSISSIPPI  
BOARD OF WATER COMMISSIONERS  
416 North State Street  
Jackson, Mississippi 39201

CODED

WATER WELL DRILLERS LOG

8-27-1973 per Martin Water Well Walthall  
date well completed firm name county well located

| LANDOWNER: <u>Mrs William E. Jones</u><br><u>RT 4</u> | description of formations encountered | from                                       | to              |
|---|---------------------------------------|--|-----------------|
|   |                                       | <u>Zylertown Mass</u><br>(mailing address) | <u>Top Clay</u> |
|   | <u>Fine Sand</u>                      | <u>18</u>                                  | <u>46</u>       |
|   | <u>red chert</u>                      | <u>46</u>                                  | <u>50</u>       |
|   | <u>Gravel</u>                         | <u>50</u>                                  | <u>54</u>       |
|   | <u>fine sand</u>                      | <u>54</u>                                  | <u>65</u>       |
|   | <u>Water Sand</u>                     | <u>65</u>                                  | <u>94</u>       |

WELL LOCATION:  
sec. 14 T. 2 N. R. 10 E  
1/4 miles West of Zylertown  
(distance) (direction) (nearest town)

WELL PURPOSE: Home  
(home, irrigation, municipal, industrial)

- WELL COMPLETION DATA:
- (1) diameter (inches) 4"
  - (2) total depth (feet) 94
  - (3) static water level (feet) 60 below above top of ground.
  - (4) casing PVC, 74,  
(material) (depth)  
4" if telescope see back.  
(size)
  - (5) screen 10x4", 74  
(length) (depth to top)  
4", sch 40 pvc  
(size) (material)
  - (6) pump 1/2, 8  
(HP) (yield gpm)  
220 Volts AC  
(type power)
  - (7) electric log (yes or no)
- (organization running log)

CODED


SEP 6 1973

(8) how well bottom plugged  
2" sand & 5" pebbles

DRILLERS REMARKS:

If well telescopes please sketch and show depths.

GROUND LEVEL

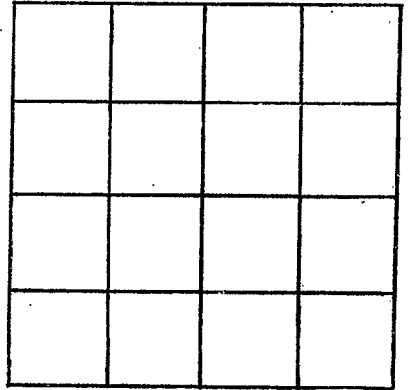

SECTION \_\_\_\_\_

Please indicate well location X.

ADDITIONAL INFORMATION

If more than one screen,  
show locations of each on sketch.