

WALTHALL
E 126
8-29-73

MISSISSIPPI
BOARD OF WATER COMMISSIONERS
416 North State Street
Jackson, Mississippi 39201

CODED


WATER WELL DRILLERS LOG

8-29-1973 Red Martin Water Well Walthall
date well completed firm name county well located

LANDOWNER: Mrs. A. M. Anderson RT 4	description of formations encountered	from	to
Tylertown miss (mailing address)	Top Clay	0	20
WELL LOCATION: sec. 14 T. 2 N. R. 10 E S W 1 1/2 miles west of Tylertown miss (distance) (direction) (nearest town)	Fine sand	20	65
WELL PURPOSE: Home (home, irrigation, municipal, industrial)	Gravel	65	72
WELL COMPLETION DATA: (1) diameter (inches) 4" (2) total depth (feet) 90' (3) static water level (feet) 60' below above top of ground. (4) casing p.v.c. 80' (material) (depth) 4" (size) if telescope see back. (5) screen 10' (length) (depth to top) 4" sch 40 p.v.c. (size) (material) (6) pump 1/2 (HP) 8 (yield gpm) 220 Volts AC (type power) (7) electric log (yes or no) (organization running log) (8) how well bottom plugged 2" sand pack valve	Fine sand	72	78
	Course water sand	78	90
	CODED		
DRILLERS REMARKS:	SEP 6 1973		

If well telescopes please sketch and show depths.

GROUND LEVEL

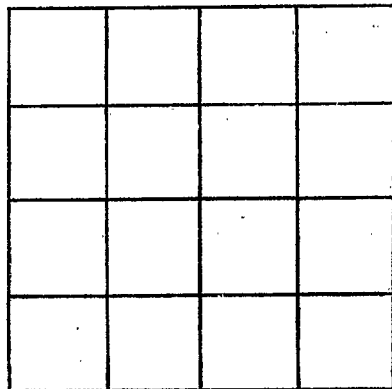

SECTION _____

Please indicate well location X.

ADDITIONAL INFORMATION

If more than one screen,
show locations of each on sketch.