

WALTHALL
E 127
10-8-73

MISSISSIPPI
BOARD OF WATER COMMISSIONERS
416 North State Street
Jackson, Mississippi 39201

OCT 19 1973
CODED
Water Comm

WATER WELL DRILLERS LOG

10-8-1973 date well completed
Perimeter Water Well Drilling firm name
Walthall county well located

LANDOWNER Adla Smith
RT-4
Zylstra miss
(mailing address)

description of formations encountered	from	to
Top clay	0	18
fine sand	18	44
pea gravel	44	50
fine sand	50	54
gravel	54	57
fine sand	57	70
Coarse sand	70	95

WELL LOCATION:
sec 5 T 20 S R 10 E W
3 1/2 miles West of Zylstra miss
(distance) (direction) (nearest town)

WELL PURPOSE:
(home, irrigation, municipal, industrial)

WELL COMPLETION DATA:
(1) diameter (inches) 4"
(2) total depth (feet) 95'
(3) static water level (feet) 80 below above top of ground.
(4) casing 4" pvc 95'
(material) (depth)
(size) If telescope see back.
(5) screen 10' 85'
(length) (depth to top)
.012 sch 40 pvc
(size) (material)
(6) pump 1/2 8
(HP) (yield gpm)
110 Volt AC
(type power)
(7) electric log (yes or no)
(organization running log)


CODED

(8) how well bottom plugged
2" sand screen bag wash

DRILLERS REMARKS:

If well telescopes please sketch and show depths.

GROUND LEVEL

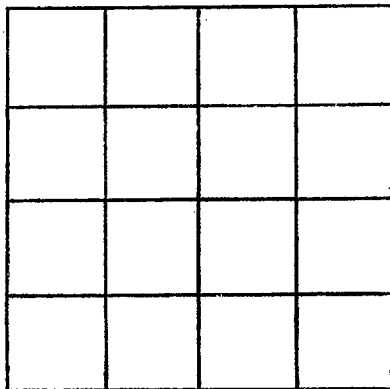

SECTION _____

Please indicate well location X.

ADDITIONAL INFORMATION

If more than one screen,
show locations of each on sketch.