

WALTHALL
E 128
8-31-73

MISSISSIPPI
BOARD OF WATER COMMISSIONERS
416 North State Street
Jackson, Mississippi 39201

OCT 19 1973
CODED
MISS. BD. OF
WATER

WATER WELL DRILLERS LOG

Walthall

8-31-'73 ¹⁹ per Martin Water Well
date well completed firm name


county well located

LANDOWNER: <u>Rev. J. Burch</u>	description of formations encountered	from	to
<u>RT-1 - Varvado Lo - Tylertown Miss (mailing address)</u>	<u>Top clay</u>	<u>0</u>	<u>14</u>
	<u>Fine sand</u>	<u>14</u>	<u>35</u>
	<u>Course sand</u>	<u>45</u>	<u>63</u>
	<u>red chert</u>	<u>63</u>	<u>66</u>
	<u>Fine sand</u>	<u>66</u>	<u>70</u>
	<u>Course sand</u>	<u>70</u>	<u>80</u>
WELL LOCATION: sec <u>15</u> T <u>2</u> <u>N</u> R <u>10</u> <u>E</u> <u>1 1/2</u> miles <u>west</u> of <u>Tylertown Miss</u> (distance) (direction) (nearest town)			
WELL PURPOSE: (home, irrigation, municipal, industrial)			
WELL COMPLETION DATA: (1) diameter (inches) <u>4"</u> (2) total depth (feet) <u>80'</u> (3) static water level (feet) <u>60'</u> below above top of ground. (4) casing <u>4" PVC</u> , <u>70</u> (material) (depth) (size) if telescope see back. (5) screen <u>10'</u> , <u>70</u> (length) (depth to top) <u>.012</u> , <u>Sch. 4. PVC.</u> (size) (material) (6) pump <u>1/2</u> , <u>8</u> (HP) (yield gpm) <u>110 volt AC</u> (type power) (7) electric log (yes or no) (organization running log) (8) how well bottom plugged <u>2" sand 3 inch Bob wash</u>			
DRILLERS REMARKS:			

CODED

If well telescopes please sketch and show depths.

GROUND LEVEL

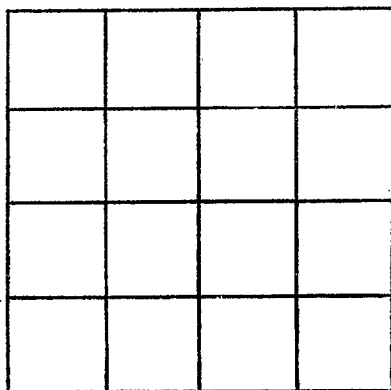

SECTION _____

Please indicate well location X.

ADDITIONAL INFORMATION

If more than one screen,
show locations of each on sketch.